





TYPICAL TOP CHORD SPLICE

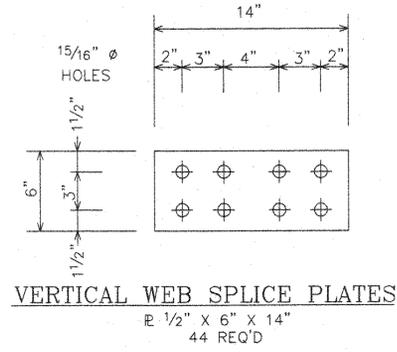


VERTICAL WEB SPLICE PLATES
1/2" X 6" X 14"
44 REQ'D

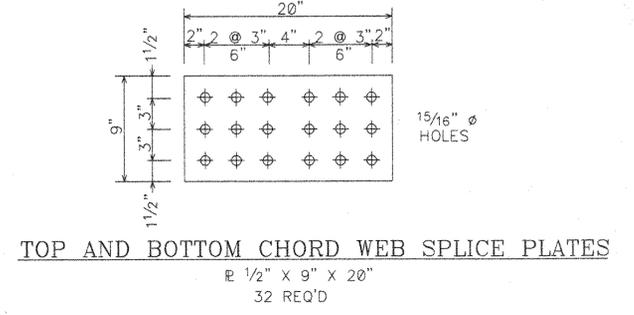


TOP AND BOTTOM CHORD WEB SPLICE PLATES
1/2" X 9" X 20"
32 REQ'D

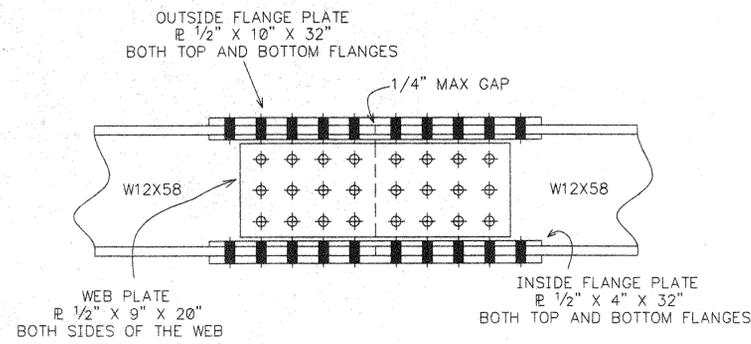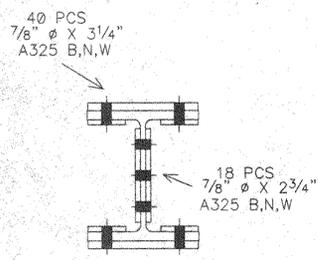


TYPICAL BOTTOM CHORD SPLICE

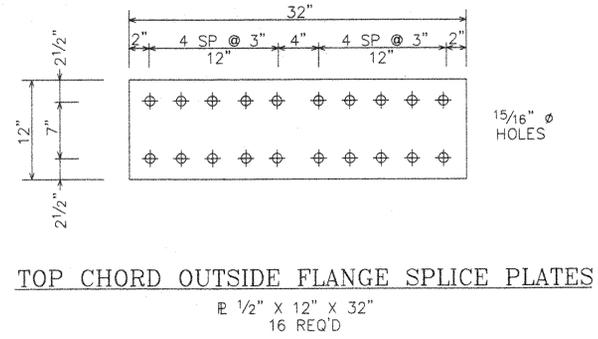


TOP CHORD OUTSIDE FLANGE SPLICE PLATES
1/2" X 12" X 32"
16 REQ'D

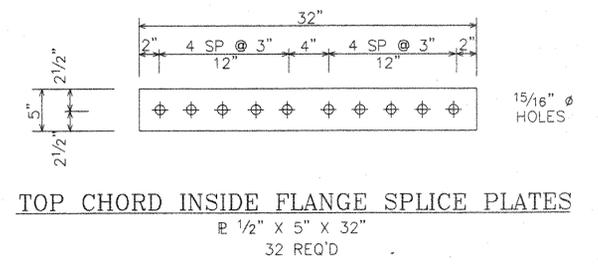



TOP CHORD INSIDE FLANGE SPLICE PLATES
1/2" X 5" X 32"
32 REQ'D

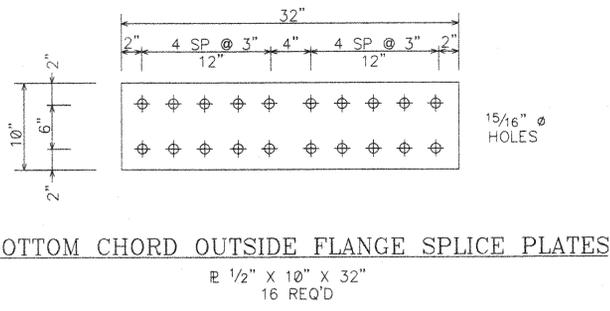


BOTTOM CHORD OUTSIDE FLANGE SPLICE PLATES
1/2" X 10" X 32"
16 REQ'D

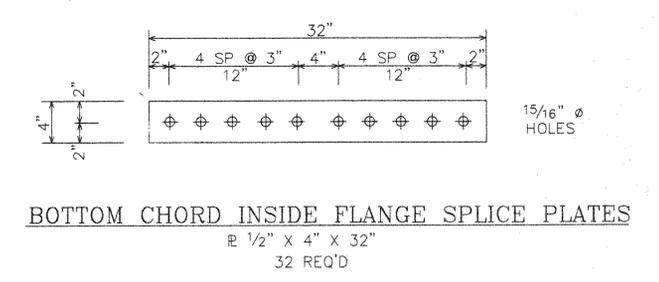


BOTTOM CHORD INSIDE FLANGE SPLICE PLATES
1/2" X 4" X 32"
32 REQ'D

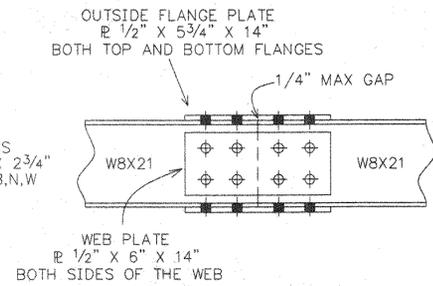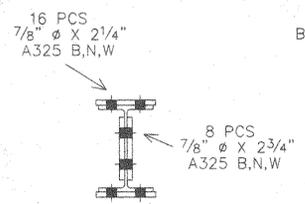



TYPICAL VERTICAL SPLICE

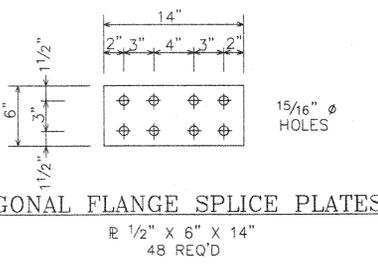

DIAGONAL FLANGE SPLICE PLATES
1/2" X 6" X 14"
48 REQ'D

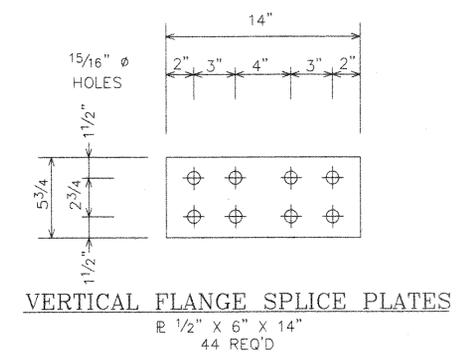

VERTICAL FLANGE SPLICE PLATES
1/2" X 6" X 14"
44 REQ'D

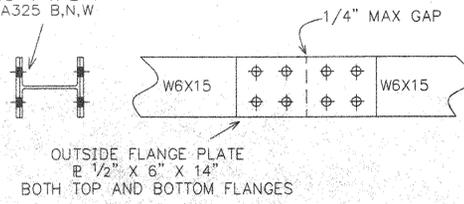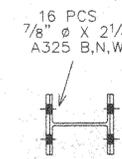

TYPICAL DIAGONAL SPLICE

NOTE: DRAWINGS RELATIVE (DO NOT SCALE)

RECEIVED
OK'D BY: *Man*
APR 23 2003
RESUBMIT: _____
APPROVED: _____
BY: _____ DATE: 4/21/03

NO.	DATE	REVISIONS	BY

564' X 12' THREE SPAN PEDESTRIAN BRIDGE
BURLINGTON - COLCHESTER
SPAN 3 - 219'-6"
CHITTENDEN COUNTY, VERMONT

DESIGN SAF	DRAWN SAF	DATE MAR. 27, 2003	DRAWING NO. BURLINGTON	SHEET
CHECK/DATE	FABRICATOR US BRIDGE		107	18 OF 18