


LEGEND

- CONCRETE MONUMENT FOUND
- IRON PIN FOUND
- EXISTING LIGHT POLE
- EXISTING HYDRANT
- EXISTING TELEPHONE MANHOLE
- EXISTING SEWER MH W/SEWER PIPE
- EXISTING MAILBOX
- EXISTING CB W/STORMWATER PIPE
- EXISTING SIGNS
- EXISTING WOOD RAIL FENCE
- EXISTING UTILITY POLE & GUY WIRE
- EXISTING TREES
- EXISTING TREE LINE
- EXISTING CONTOUR
- EXISTING WHITE LINE
- EXISTING ROAD CENTERLINE
- EXISTING FACE OF BUILDING
- LIMIT OF CONSTRUCTION
- PROPOSED MAILBOX
- PROPOSED DRAINAGE MANHOLE
- PROPOSED CB W/STORMWATER PIPE
- PROPOSED TREES
- PROPOSED TREE LINE
- PROPOSED WHITE LINE
- PROPOSED ROAD CENTERLINE
- PROPOSED PAVEMENT AND BASE
- PROPOSED SIDEWALK
- PROPOSED JUNCTION BOX, UNDERGROUND ELECTRIC & LIGHT POLE
- PROPERTY LINE
- SLOPE LIMIT (FILL)
- SLOPE LIMIT (CUT)
- FINISH GRADE ELEVATION
- PROPOSED UTILITY POLE

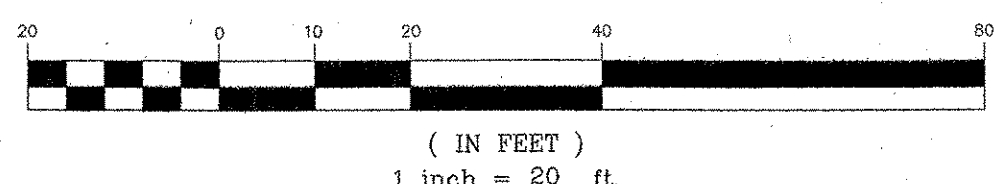

CENTERLINE DATA

TO			
14-07.15	2+22.64	S43°40'14"E	
2+22.64	3+72.63	S41°02'13"E	
3+72.63	3+92.16	S44°54'21"E	
3+92.16	4+69.65	S42°03'26"E	
4+69.65	5+87.99	S44°23'37"E	

NOTE:
 NEW 6' WIDE CONCRETE SIDEWALK AND GRANITE CURB AND RELATED ITEMS FROM STATION 0+92 TO STATION 1+80 AND THE NON-ELECTRICAL WORK SOUTHERLY OF THE LIMITS OF CONSTRUCTION ARE TO BE CONSTRUCTED BY OTHERS.


INSTALL NEW CATCH BASIN (TYPE I) WITH TYPE D GRATE 3+70, 6' RT RIM ELEV. = 485.30 12" INV. IN/OUT ELEV. = 478.90

INSTALL NEW DRAINAGE MANHOLE 3+80, 6.5' LT RIM ELEV. = 484.80 12" INV. IN ELEV. = 477.85 15" INV. OUT ELEV. = 477.85 (PLUG EXISTING 15" INVERT IN)

INSTALL NEW CATCH BASIN 2+00, 8' RIGHT RIM ELEV. = 486.87 12" INV. IN ELEV. = 481.26 12" INV. OUT ELEV. = 481.18

INSTALL NEW CATCH BASIN (TYPE I) WITH TYPE D GRATE 1+50, 9' RT RIM ELEV. = 485.70 12" INV. IN/OUT ELEV. = 481.92

18 LF OF NEW 12" CULVERT

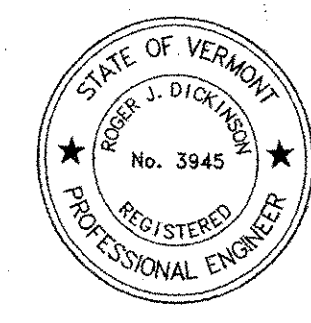

DATUM
 VERTICAL NAVD 1988
 HORIZONTAL NAD 1983

RECORD DRAWING

3-14-07	REVISED FOR RECORD INFORMATION	SA
2-3-06	REVISED CONSTRUCTION AREA	BH/DH
12-19-05	REVISED FOR BIDDERS	BH/DH
10-20-05	REVISED FOR CONTRACT PLANS	BH/DH
REVISIONS		
THESE PLANS WITH LATEST REVISIONS SHOULD ONLY BE USED FOR THE PURPOSE SHOWN BELOW:		
STP WALK (9) TOWN OF ESSEX ROUTE 15 IN ESSEX CENTER, VT		# OF SHEETS
SITE PLAN		proj. no.
STATION 0+00 TO 5+75		02-132
LAMOUREUX & DICKINSON Consulting Engineers, Inc. 14 Morse Drive Essex Junction, VT 05452 Tel. 802-878-4450		survey
scale		L&D/OTHERS
1" = 20'		design
03/01/04		DLH/LAL
scale		drawn
1" = 20'		DB
03/01/04		checked
scale		LAL/DLH
1" = 20'		date
03/01/04		scale
1" = 20'		sht. no.
03/01/04		7R
1" = 20'		02132-S1-REC