

IPF 1 IN FLUSH
ELEV = 488.25
STA. 10+89.11 OFFSET: 48.26 L
N733070.04, E1495244.51

TBM TOP OF TELEPHONE
MANHOLE, ELEV = 485.70


STA. 9+53.00
OFFSET: 41.14 L

STA. 10+52.62
OFFSET: 40.05 L

STA. 11+76.40
OFFSET: 39.61 L

MATCHLINE STA. 5+75

MATCHLINE STA. 12+25

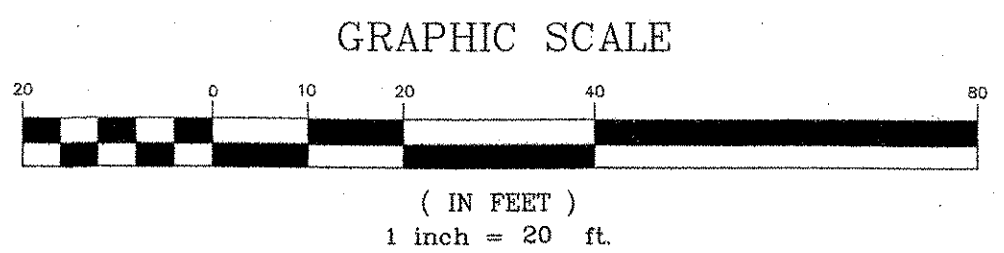

LEGEND


- CONCRETE MONUMENT FOUND
- IRON PIN FOUND
- ☆ EXISTING LIGHT POLE
- ⊕ EXISTING HYDRANT
- ⊙ EXISTING TELEPHONE MANHOLE
- ⊙-S EXISTING SEWER MH W/SEWER PIPE
- ⊙-d EXISTING MAILBOX
- ⊙-D EXISTING CB W/STORMWATER PIPE
- ⊙-S EXISTING SIGNS
- ⊙-X EXISTING WOOD RAIL FENCE
- ⊙-G EXISTING UTILITY POLE & GUY WIRE
- ⊙-T EXISTING TREES
- ⊙-L EXISTING TREE LINE
- ⊙-C EXISTING CONTOUR
- ⊙-W EXISTING WHITE LINE
- ⊙-R EXISTING ROAD CENTERLINE
- ⊙-B EXISTING FACE OF BUILDING
- ⊙-X LIMIT OF CONSTRUCTION
- ⊙-M PROPOSED MAILBOX
- ⊙-D PROPOSED DRAINAGE MANHOLE
- ⊙-D PROPOSED CB W/STORMWATER PIPE
- ⊙-T PROPOSED TREES
- ⊙-L PROPOSED TREE LINE
- ⊙-C PROPOSED STONE WALL
- ⊙-W PROPOSED WHITE LINE
- ⊙-R PROPOSED ROAD CENTERLINE
- ⊙-B PROPOSED PAVEMENT AND BASE
- ⊙-S PROPOSED SIDEWALK
- ⊙-L PROPERTY LINE
- ⊙-C SLOPE LIMIT (FILL)
- ⊙-W SLOPE LIMIT (CUT)
- ⊙-R FINISH GRADE ELEVATION
- ⊙-B PROPOSED UTILITY POLE
- ⊙-X PROPOSED STONE FILL

CENTERLINE DATA

TO		
4+69.65	5+87.99	S44°23'37"E
5+87.99	6+01.06	S34°44'28"E
6+01.06	6+11.33	S45°00'00"E
6+11.33	6+26.20	S67°05'17"E
6+26.20	6+50.00	S44°21'48"E
6+50.00	7+01.31	S43°18'58"E
7+01.31	7+51.31	S44°01'41"E
7+51.31	8+26.32	S43°25'26"E
8+26.32	8+40.22	S38°28'41"E
8+40.22	8+74.73	S43°35'32"E
8+74.73	9+29.80	S42°52'08"E
9+29.80	10+21.10	S44°04'32"E
10+21.10	10+88.24	S45°33'36"E
10+88.24	11+87.47	S43°42'05"E
11+87.47	11+99.95	S45°04'20"E
11+99.95	12+49.98	S51°33'35"E

RECORD DRAWING

3-14-07	REVISED FOR RECORD INFORMATION	SA
12-19-05	REVISED FOR BIDDERS	BH/DH
10-20-05	REVISED FOR CONTRACT PLANS	BH/DH
REVISIONS		
THESE PLANS WITH LATEST REVISIONS SHOULD ONLY BE USED FOR THE PURPOSE SHOWN BELOW:		
STP WALK (9) TOWN OF ESSEX ROUTE 15 IN ESSEX CENTER, VT		# OF SHEETS
SITE PLAN STATION 5+75 TO 12+25		proj. no. 02-132
		survey L&D/OTHERS
		design DLH/LAL
		drawn DB
		checked LAL/DLH
		date 03/01/04
		scale 1" = 20'
		sht. no. 8R
		02132-52

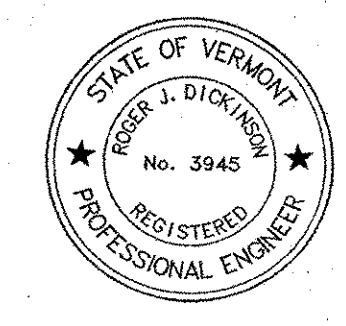

DATUM
VERTICAL NAVD 1988
HORIZONTAL NAD 1983

LAMOREUX & DICKINSON
Consulting Engineers, Inc.
14 Mars Drive
Essex Junction, VT 05452
Tel: 802-878-4450