


TRAVERSE BAR 13  
 ELEV = 491.22  
 STA. 14+92.48 OFFSET: 24.61 L  
 N732760.82, E1495511.62

EXISTING CATCH BASIN  
 RIM ELEV. = 487.70  
 12" INV. IN ELEV. = 484.21  
 12" INV. OUT ELEV. = 484.14

TBM - SEWER MANHOLE RIM  
 ELEV = 489.14

EXISTING CATCH BASIN  
 RIM ELEV. = 488.75  
 12" INV. ELEV. = 485.26  
 REMOVE EXISTING FRAME & GRATE & INSTALL  
 NEW CAST IRON GRATE AND FRAME, TYPE A  
 (MODIFIED - CURB INLET - NEENAH R-3303  
 OR APPROVED EQUAL) WITH SOLID COVER AT  
 FINISH GRADE. PAVE APRON BETWEEN  
 EXISTING EDGE OF PAVEMENT AND INLET.

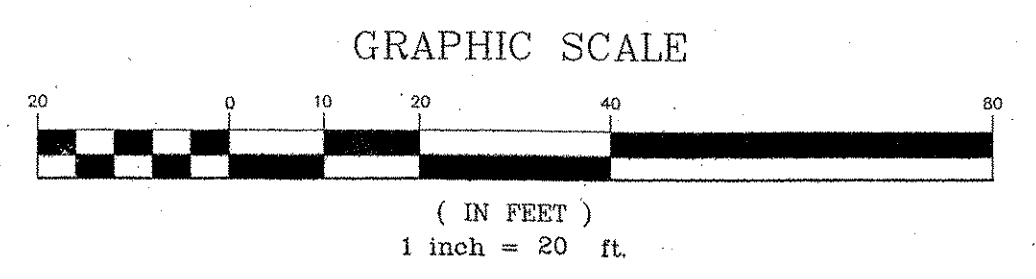

**LEGEND**

- CONCRETE MONUMENT FOUND
- IRON PIN FOUND
- EXISTING LIGHT POLE
- EXISTING HYDRANT
- EXISTING TELEPHONE MANHOLE
- EXISTING SEWER MH W/SEWER PIPE
- EXISTING MAILBOX
- EXISTING CB W/STORMWATER PIPE
- EXISTING SIGNS
- EXISTING WOOD RAIL FENCE
- EXISTING UTILITY POLE & GUY WIRE
- EXISTING TREES
- EXISTING TREE LINE
- EXISTING CONTOUR
- EXISTING WHITE LINE
- EXISTING ROAD CENTERLINE
- EXISTING FACE OF BUILDING
- LIMIT OF CONSTRUCTION
- PROPOSED MAILBOX
- PROPOSED DRAINAGE MANHOLE
- PROPOSED CB W/STORMWATER PIPE
- PROPOSED TREES
- PROPOSED TREE LINE
- PROPOSED WHITE LINE
- PROPOSED ROAD CENTERLINE
- PROPOSED PAVEMENT AND BASE
- PROPOSED SIDEWALK
- PROPERTY LINE
- SLOPE LIMIT (FILL)
- SLOPE LIMIT (CUT)
- FINISH GRADE ELEVATION
- PROPOSED UTILITY POLE


**CENTERLINE DATA**

TO		
11+99.95	12+49.98	S51°33'35"E
12+49.98	12+72.77	S44°41'19"E
12+72.77	12+81.42	S45°04'20"E
12+81.42	13+01.68	S45°50'31"E
13+01.68	13+21.44	S45°13'54"E
13+21.44	13+35.23	S47°09'02"E
13+35.23	13+47.43	S48°18'05"E
13+47.43	13+67.42	S47°56'04"E
13+67.42	13+80.44	S47°59'26"E
13+80.44	13+90.99	S45°00'52"E
13+90.99	14+01.73	S44°03'22"E
14+01.73	14+03.51	S42°21'38"E
14+03.51	14+05.54	S42°21'25"E
14+05.54	14+08.57	S42°21'43"E
14+08.57	14+10.75	S42°08'04"E
14+10.75		
15+72.89	EXISTING SIDEWALK	
15+72.89	15+75.43	S23°28'14"E
15+75.43	16+99.39	S27°18'18"E
16+99.39	17+14.98	S29°09'25"E
17+14.98	17+29.45	S29°14'05"E
17+29.45	17+34.21	S28°27'57"E
17+34.21	17+51.95	S17°38'29"E
17+51.95	17+56.14	S28°37'56"E
17+56.14	17+60.43	S29°36'56"E

**RECORD DRAWING**

3-14-07	REVISED FOR RECORD INFORMATION	SA
12-19-05	REVISED FOR BIDDERS	BH/DH
10-20-05	REVISED FOR CONTRACT PLANS	BH/DH
REVISIONS		
THESE PLANS WITH LATEST REVISIONS SHOULD ONLY BE USED FOR THE PURPOSE SHOWN BELOW:		
<b>STP WALK (9) TOWN OF ESSEX ROUTE 15 IN ESSEX CENTER, VT</b>		# OF SHEETS 02-132
<b>SITE PLAN STATION 12+25 TO 17+60.43</b>		proj. no. 02-132
		survey L&D/OTHERS
		design DLH/LAL
		drawn DB
		checked LAL/DLH
		date 03/01/04
		scale 1" = 20'
		sht. no. <b>9R</b>

DATUM  
 VERTICAL NAVD 1988  
 HORIZONTAL NAD 1983

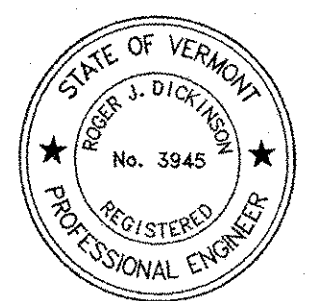

**LAMOREUX & DICKINSON**  
 Consulting Engineers, Inc.  
 14 Morse Drive  
 Essex Junction, VT 05452  
 Tel: 802-878-4450