




SIDEWALK PROFILE

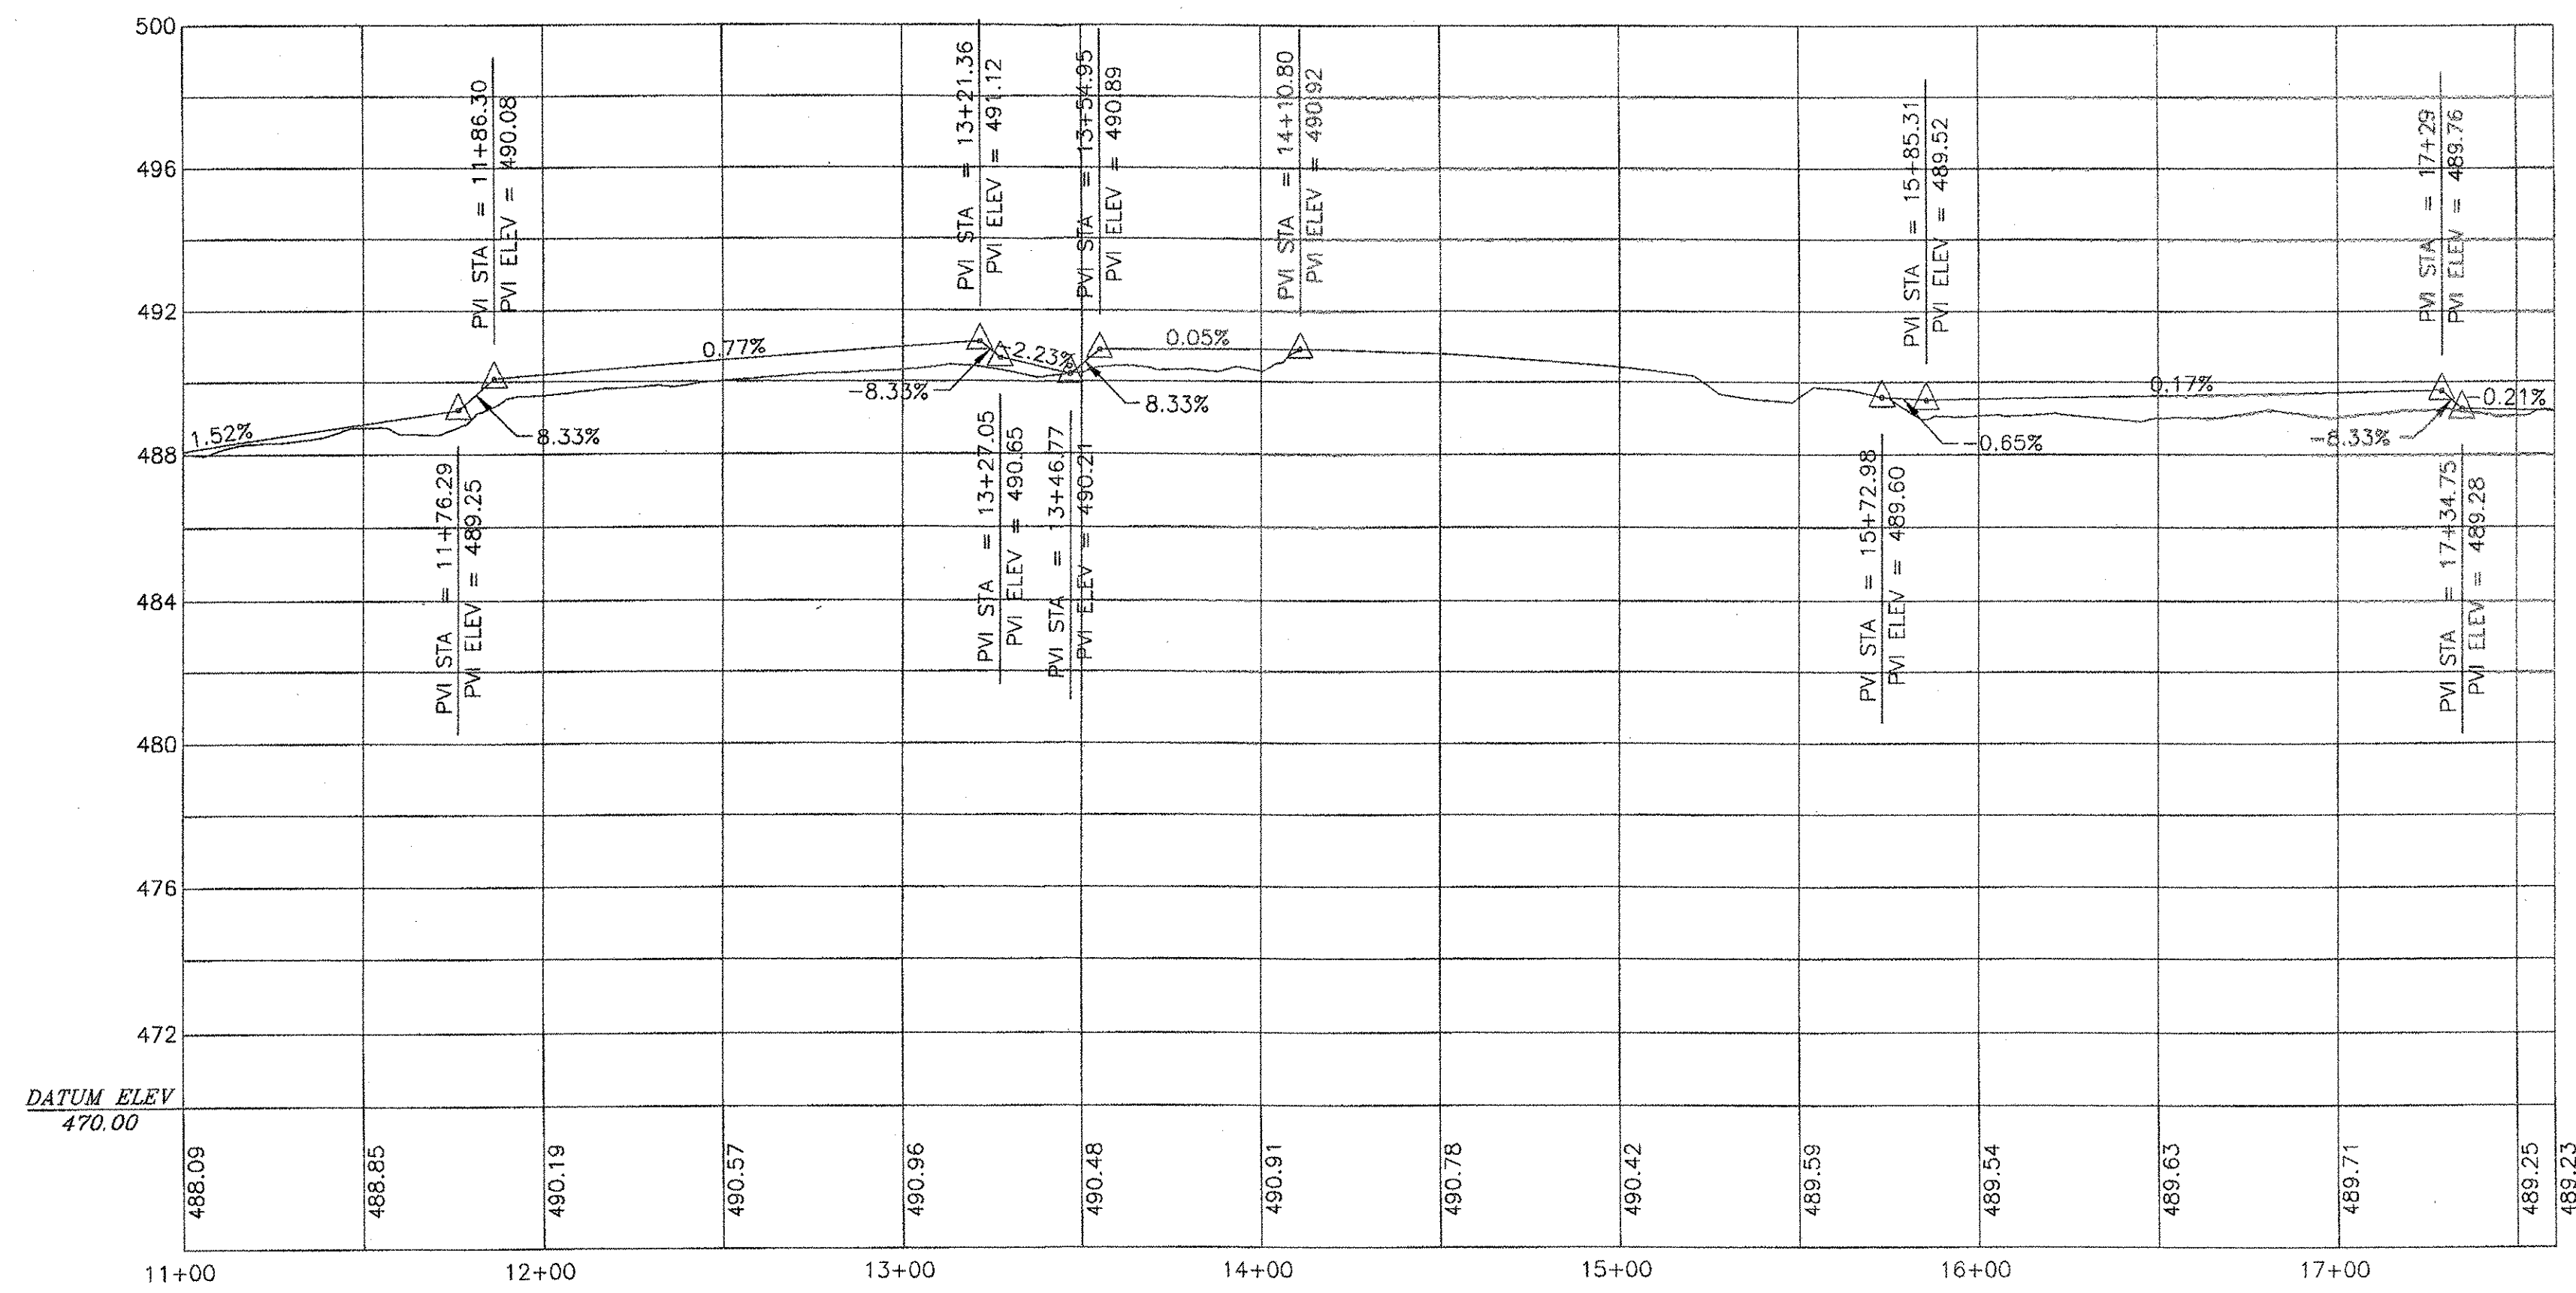


SIDEWALK PROFILE

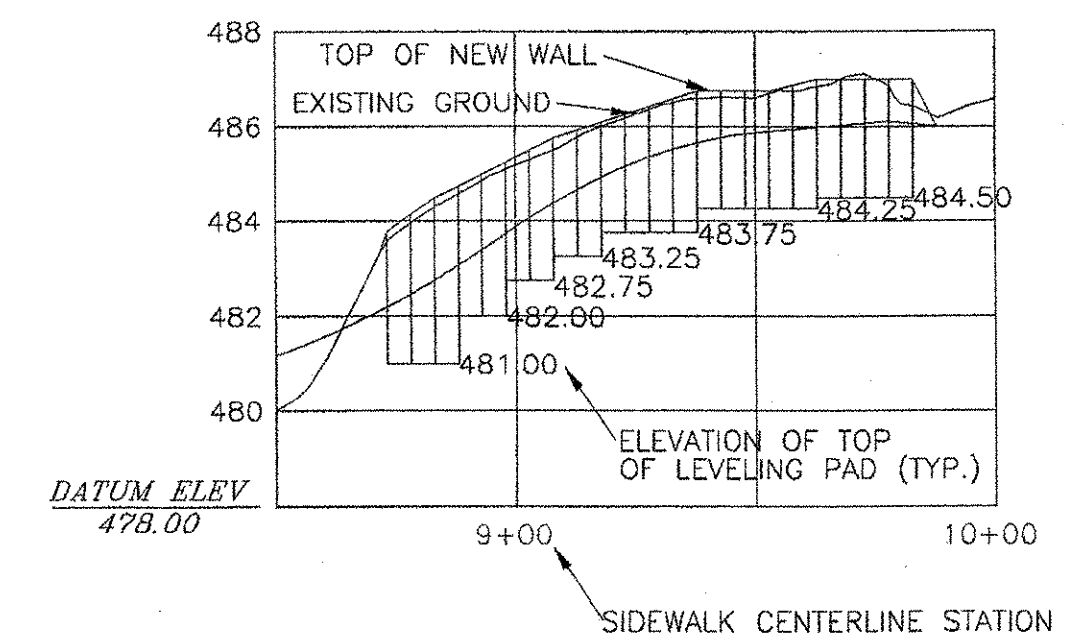

RETAINING WALL PROFILE

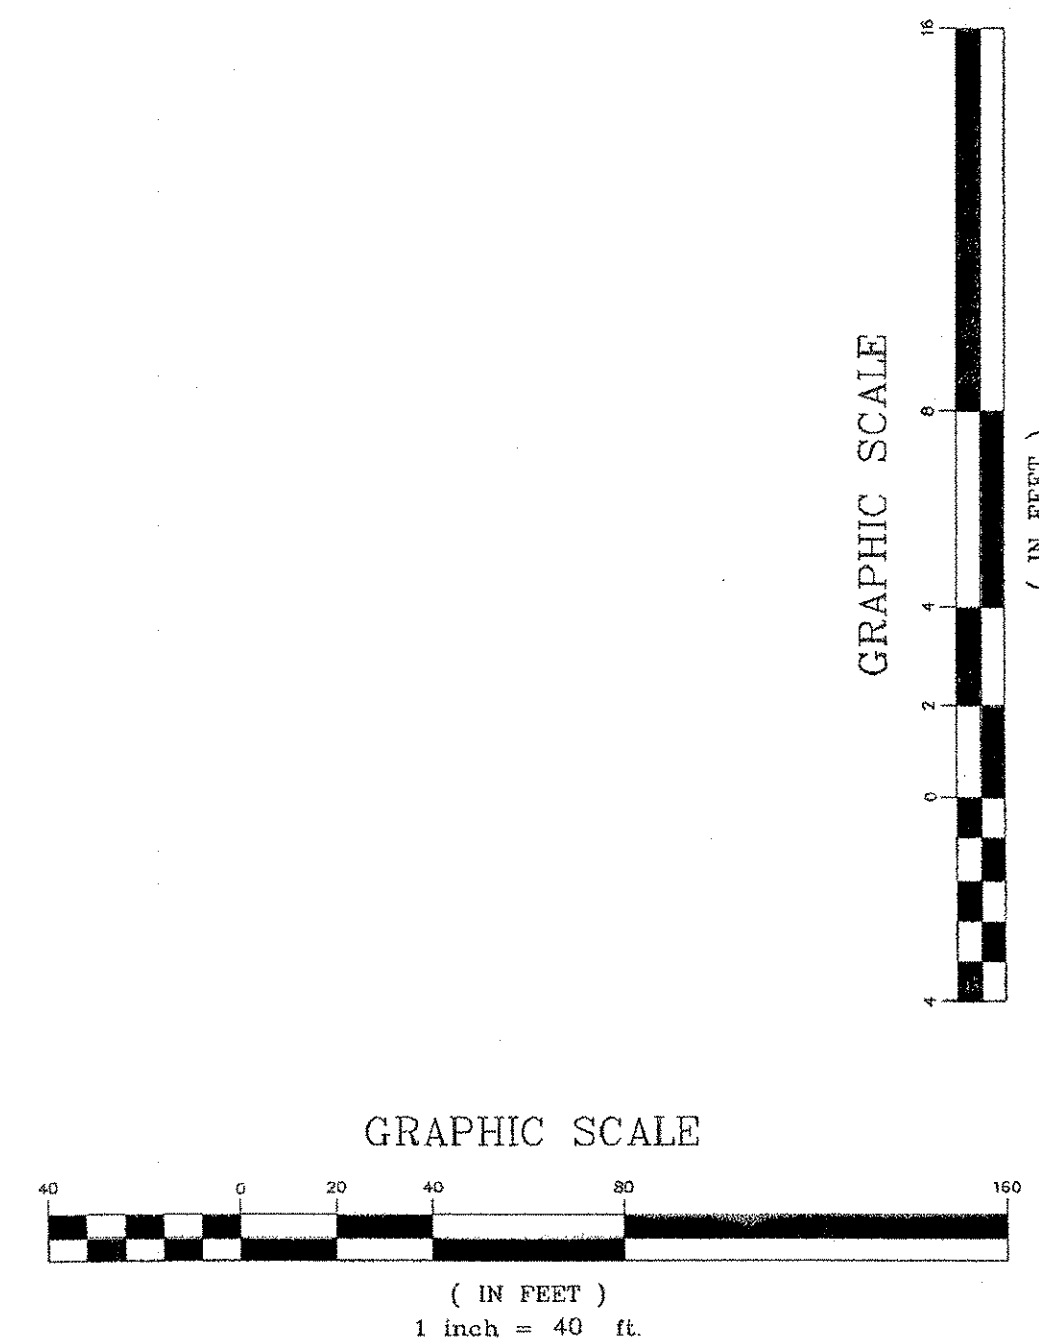

10-20-05	REVISED FOR CONTRACT PLANS	BH/DH
REVISIONS		
THESE PLANS WITH LATEST REVISIONS SHOULD ONLY BE USED FOR THE PURPOSE SHOWN BELOW:		
STP WALK (9) TOWN OF ESSEX ROUTE 15 IN ESSEX CENTER, VT		# OF SHEETS
ESSEX STP WALK (9) PROJECT CENTERLINE PROFILE		proj. no. 02-132
		survey
		L&D/OTHERS
		design
		DLH/LAL
		drown
		DB
		checked
		LAL/DLH
		date
		03/01/04
		scale
		H: 1"=40'
		V: 1"=4'
		sht. no.
		18
 LAMOREUX & DICKINSON Consulting Engineers, Inc. 14 Morse Drive Essex Junction, VT 05452 Tel: 802-878-4150		