

MUNSON AND BELGRADE SILT LOAMS, 12 TO 25 PERCENT SLOPES	
HYDROLOGIC SOIL GROUP	D
DEPTH TO BEDROCK	5'+
DEPTH TO WATER TABLE	0.5'-2.0'
K - FACTOR	0.49
HIGHLY ERODIBLE	

ADAMS & WINDSOR LOAMY SANDS, 0%-5% SLOPES	
HYDROLOGIC SOIL GROUP	A
DEPTH TO BEDROCK	5'+
DEPTH TO WATER TABLE	4'+
K - FACTOR	0.17
LOW ERODIBILITY	

HARTLAND VERY FINE SANDY LOAM, 25 TO 60 PERCENT SLOPES	
HYDROLOGIC SOIL GROUP	B
DEPTH TO BEDROCK	5'+
DEPTH TO WATER TABLE	3'+
K - FACTOR	0.49
HIGHLY ERODIBLE	


MuD

Ada

HIE


LEGEND

- CONCRETE MONUMENT FOUND
- IRON PIN FOUND
- ☆ EXISTING LIGHT POLE
- ⊕ EXISTING HYDRANT
- ⊙ EXISTING TELEPHONE MANHOLE
- ⊙-S EXISTING SEWER MH W/SEWER PIPE
- ⊙-P EXISTING MAILBOX
- ⊙-W EXISTING CB W/STORMWATER PIPE
- ⊙ EXISTING SIGNS
- x-x-x-x EXISTING WOOD RAIL FENCE
- ⊕ EXISTING UTILITY POLE & GUY WIRE
- ⊕ EXISTING TREES
- ⊕ EXISTING TREE LINE
- 487 EXISTING CONTOUR
- EXISTING WHITE LINE
- EXISTING ROAD CENTERLINE
- ▨ EXISTING FACE OF BUILDING
- - - - - PROPERTY LINE

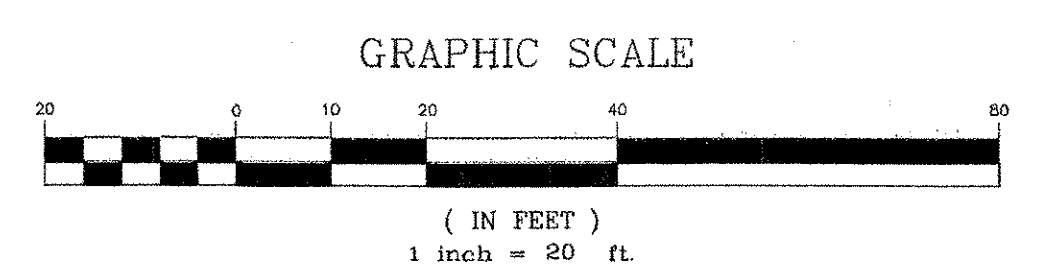

NOTE:
WITH THE EXCEPTION OF THE PAVED, CONCRETE & WOODED AREAS NOTED ABOVE, THE VEGETATION COVER IS GRASS IN THE AREA BETWEEN THE BUILDINGS AND THE ROAD.

NOTE:
SOIL PROPERTIES AND BOUNDARIES WERE APPROXIMATED BASED ON USDA SOIL SURVEY, ACTUAL FIELD CONDITIONS MAY VARY.

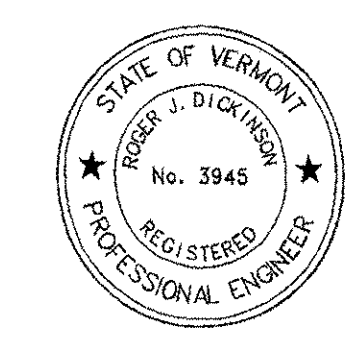

DATUM
VERTICAL NAVD 1988
HORIZONTAL NAD 1983

REVISIONS	
THESE PLANS WITH LATEST REVISIONS SHOULD ONLY BE USED FOR THE PURPOSE SHOWN BELOW:	# OF SHEETS
STP WALK (9) TOWN OF ESSEX ROUTE 15 IN ESSEX CENTER, VT	proj. no. 02-132
EXISTING CONDITIONS STATION 5+75 TO 12+25	survey &D/OTHERS
	design DLH/LAL
	drawn DB
	checked LAL/DLH
	date 03/01/04
	scale 1" = 20'
	sht. no. 25D
	02132-25D

LAMOREUX & DICKINSON
Consulting Engineers, Inc.
14 Morse Drive
Essex Junction, VT 05452
Tel: 802-878-4450

EROSION & SEDIMENT CONTROL PLANS

