


MATCHLINE STA. 5+75

MATCHLINE STA. 12+25

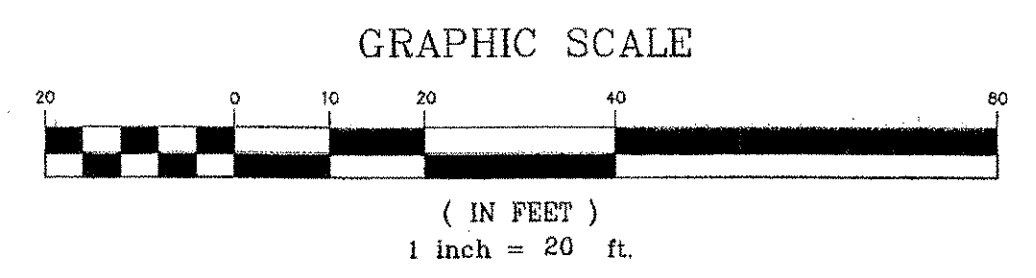


LEGEND

- CONCRETE MONUMENT FOUND
- IRON PIN FOUND
- ⊙ EXISTING LIGHT POLE
- ⊕ EXISTING HYDRANT
- ⊗ EXISTING TELEPHONE MANHOLE
- ⊘ EXISTING SEWER MH W/SEWER PIPE
- ⊙ EXISTING CB W/STORMWATER PIPE
- ⊙ EXISTING SIGNS
- ⊗ EXISTING WOOD RAIL FENCE
- ⊕ EXISTING UTILITY POLE & GUY WIRE
- ⊗ EXISTING TREES
- ⊗ EXISTING TREE LINE
- ⊗ EXISTING CONTOUR
- ⊗ EXISTING WHITE LINE
- ⊗ EXISTING ROAD CENTERLINE
- ⊗ EXISTING FACE OF BUILDING
- ⊙ PROPOSED MAILBOX
- ⊙ PROPOSED DRAINAGE MANHOLE
- ⊙ PROPOSED CB W/STORMWATER PIPE
- ⊙ PROPOSED TREES
- ⊙ PROPOSED TREE LINE
- ⊙ PROPOSED ROAD CENTERLINE
- ⊙ PROPOSED PAVEMENT AND BASE
- ⊙ PROPOSED SIDEWALK
- ⊙ PROPOSED JUNCTION BOX, UNDERGROUND ELECTRIC & LIGHT POLE
- ⊙ PROPERTY LINE
- ⊙ SLOPE LIMIT (FILL)
- ⊙ SLOPE LIMIT (CUT)
- ⊙ FINISH GRADE ELEVATION
- ⊙ PROPOSED UTILITY POLE
- ⊙ PROPOSED STONE FILL

EROSION & SEDIMENT CONTROL PLANS

EROSION & SEDIMENT CONTROL KEY

- ➔ (A) DIRECTIONAL FLOW ARROW
- ⊗ (B) TEMPORARY SILT FENCE
- ⊙ (C) INLET PROTECTION AT CATCH BASINS
- ⊙ (D) AREA TO BE SEEDED AND MULCHED
- ⊙ (E) PROJECT DEMARCATION FENCE SET AT LIMITS OF DISTURBANCE - DELINEATED WITH SNOW FENCE (MODIFIED) EXCEPT ACROSS DRIVEWAYS, PARKING AREAS, ROADS AND PAVED WALKS.

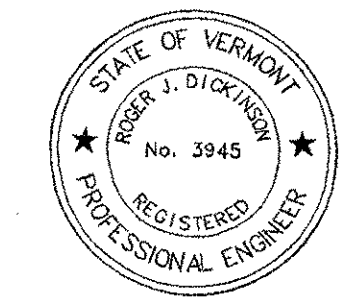

DATUM
 VERTICAL NAVD 1988
 HORIZONTAL NAD 1983

10-20-05	REVISED FOR CONTRACT PLANS	BH/DLH
REVISIONS		
THESE PLANS WITH LATEST REVISIONS SHOULD ONLY BE USED FOR THE PURPOSE SHOWN BELOW:		# OF SHEETS
STP WALK (9) TOWN OF ESSEX		proj. no. 02-132
ROUTE 15 IN ESSEX CENTER, VT		survey L&D/OTHERS
EROSION PREVENTION AND SEDIMENT CONTROL PLAN		design DLH/LAL
STATION 5+75 TO STA. 12+25		drawn DB/BH
		checked LAL/DLH
		date 03/01/04
		scale 1" = 20'
		sht. no. 25G
		02132-25G

LAMOREUX & DICKINSON
 Consulting Engineers, Inc.
 14 Morse Drive
 Essex Junction, VT 05452
 Tel: 802-878-4450