



**LEGEND**

- |   |   |
|---|---|
| <ul style="list-style-type: none"> <li>■ CONCRETE MONUMENT FOUND</li> <li>○ IRON PIN FOUND</li> <li>☆ EXISTING LIGHT POLE</li> <li>⊕ EXISTING HYDRANT</li> <li>⊙ EXISTING TELEPHONE MANHOLE</li> <li>⊙-S EXISTING SEWER MH W/SEWER PIPE</li> <li>⊙ EXISTING MAILBOX</li> <li>⊙ EXISTING CB W/STORMWATER PIPE</li> <li>⊙ EXISTING SIGNS</li> <li>⊙ EXISTING WOOD RAIL FENCE</li> <li>⊙ EXISTING UTILITY POLE &amp; GUY WIRE</li> <li>⊙ EXISTING TREES</li> <li>⊙ EXISTING TREE LINE</li> <li>⊙ EXISTING CONTOUR</li> <li>⊙ EXISTING WHITE LINE</li> <li>⊙ EXISTING ROAD CENTERLINE</li> <li>⊙ EXISTING FACE OF BUILDING</li> </ul> | <ul style="list-style-type: none"> <li>⊙ PROPOSED MAILBOX</li> <li>⊙ PROPOSED DRAINAGE MANHOLE</li> <li>⊙ PROPOSED CB W/STORMWATER PIPE</li> <li>⊙ PROPOSED TREES</li> <li>⊙ PROPOSED TREE LINE</li> <li>⊙ PROPOSED WHITE LINE</li> <li>⊙ PROPOSED ROAD CENTERLINE</li> <li>⊙ PROPOSED PAVEMENT AND BASE</li> <li>⊙ PROPOSED SIDEWALK</li> <li>⊙ PROPERTY LINE</li> <li>⊙ SLOPE LIMIT (FILL)</li> <li>⊙ SLOPE LIMIT (CUT)</li> <li>⊙ FINISH GRADE ELEVATION</li> <li>⊙ LIMIT OF CONSTRUCTION</li> <li>⊙ NEW SIGN OR POST</li> <li>⊙ SALVAGED SIGN OR POST</li> <li>⊙ BIKEWAY SYMBOL PAVEMENT MARKINGS - DURABLE WHITE AND GRITTED SUITABLE FOR BIKES</li> </ul> |
|---|---|

NOTE: CROSS SECTIONS ARE BEING USED TO SHOW CHANGES IN CONTOURS. SEE PLAN SHEETS 25A-25L.

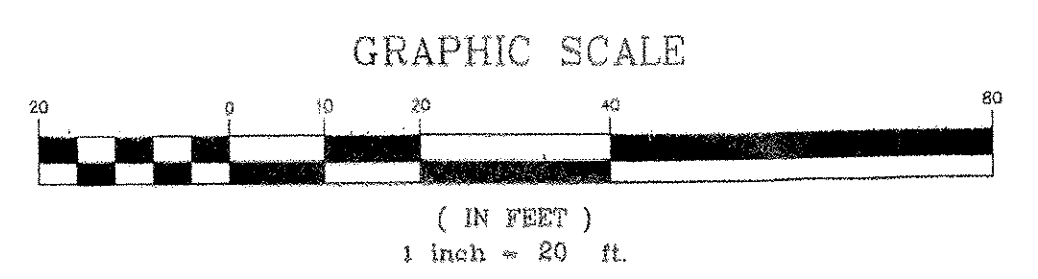

**EROSION & SEDIMENT CONTROL PLANS**

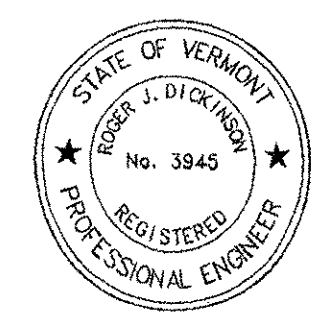

DATUM  
 VERTICAL NAVD 1988  
 HORIZONTAL NAD 1983

REVISIONS		# OF SHEETS
THESE PLANS WITH LATEST REVISIONS SHOULD ONLY BE USED FOR THE PURPOSE SHOWN BELOW:		
<b>STP WALK (9)</b>		proj. no. 02-132
<b>TOWN OF ESSEX</b>		survey
ROUTE 15 IN ESSEX CENTER, VT		L&D/OTHERS
<b>FINAL CONDITIONS</b>		design DLH/LAL
STATION 0+00 TO 5+75		drawn DB
		checked LAL/DLH
		date 03/01/04
		scale 1" = 20'
		sht. no. <b>25J</b>
		02132-25J

**LAMOUREUX & DICKINSON**  
 Consulting Engineers, Inc.  
 14 Morse Drive  
 Essex Junction, VT 05452  
 Tel: 802-878-4450