

ROMAN CATHOLIC DIOCESE  
ST. PIUS X  
N/F

PETER LYON  
N/F

VERMONT ROUTE 15

SAND HILL ROAD

KATHERINE S. REYNOLDS  
FAMILY TRUST &  
RAYMOND H. REYNOLDS  
FAMILY TRUST  
N/F

DOROTHY BURBO  
N/F

CHRISTOPHER T. LYON &  
KRISTEN T. LYON  
N/F



VICTOR & THERESA LOYA  
N/F

TOWN OF ESSEX  
N/F

### EROSION & SEDIMENT CONTROL PLANS

#### LEGEND

- CONCRETE MONUMENT FOUND
- IRON PIN FOUND
- ⊙ EXISTING LIGHT POLE
- ⊕ EXISTING HYDRANT
- ⊙ EXISTING TELEPHONE MANHOLE
- ⊙ EXISTING SEWER MH W/SEWER PIPE
- ⊙ EXISTING MAILBOX
- ⊙ EXISTING CB W/STORMWATER PIPE
- ⊙ EXISTING SIGNS
- ⊙ EXISTING WOOD RAIL FENCE
- ⊙ EXISTING UTILITY POLE & GUY WIRE
- ⊙ EXISTING TREES
- ⊙ EXISTING TREE LINE
- ⊙ EXISTING CONTOUR
- ⊙ EXISTING WHITE LINE
- ⊙ EXISTING ROAD CENTERLINE
- ⊙ EXISTING FACE OF BUILDING
- ⊙ PROPOSED MAILBOX
- ⊙ PROPOSED DRAINAGE MANHOLE
- ⊙ PROPOSED CB W/STORMWATER PIPE
- ⊙ PROPOSED TREES
- ⊙ PROPOSED TREE LINE
- ⊙ PROPOSED WHITE LINE
- ⊙ PROPOSED ROAD CENTERLINE
- ⊙ PROPOSED PAVEMENT AND BASE
- ⊙ PROPOSED SIDEWALK
- ⊙ PROPERTY LINE
- ⊙ SLOPE LIMIT (FILL)
- ⊙ SLOPE LIMIT (CUT)
- ⊙ FINISH GRADE ELEVATION
- ⊙ LIMIT OF CONSTRUCTION
- ⊙ NEW SIGN OR POST
- ⊙ SALVAGED SIGN OR POST
- ⊙ BIKEWAY SYMBOL PAVEMENT MARKINGS - DURABLE WHITE AND CRITTED SUITABLE FOR BIKES

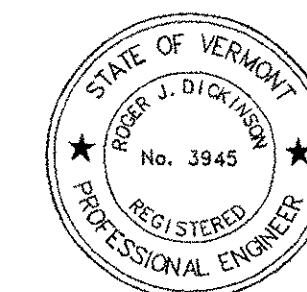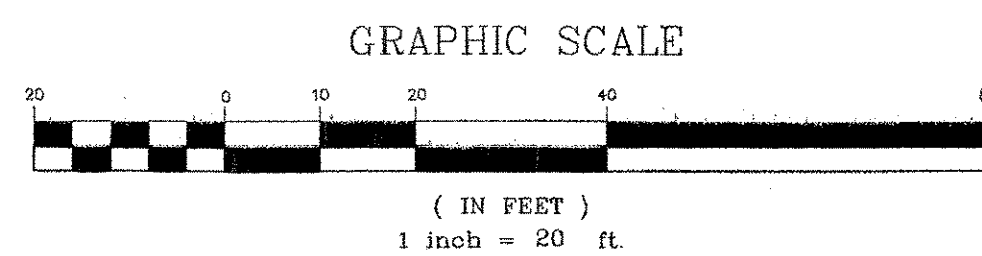

DATUM  
VERTICAL NAVD 1988  
HORIZONTAL NAD 1983

REVISIONS		# OF SHEETS
THESE PLANS WITH LATEST REVISIONS SHOULD ONLY BE USED FOR THE PURPOSE SHOWN BELOW:		proj. no. 02-132
STP WALK (9) TOWN OF ESSEX ROUTE 15 IN ESSEX CENTER, VT		survey & D/OTHERS
FINAL CONDITIONS STATION 12+25 TO 17+60.43		design DLH/LAL
		drawn DB
		checked LAL/DLH
		date 03/01/04
		scale 1" = 20'
		sht. no. 25L
		02132-25L

**L** LAMOUREUX & DICKINSON  
Consulting Engineers, Inc.  
14 Morse Drive  
Essex Junction, VT 05452  
Tel: 802-878-4450