


**LEGEND**


- CONCRETE MONUMENT FOUND
- IRON PIN FOUND
- ☆ EXISTING LIGHT POLE
- ⊕ EXISTING HYDRANT
- ⊙ EXISTING TELEPHONE MANHOLE
- ⊙ EXISTING SEWER MH W/SEWER PIPE
- ⊙ EXISTING MAILBOX
- ⊙ EXISTING CB W/STORMWATER PIPE
- ⊙ EXISTING SIGNS
- ⊙ EXISTING WOOD RAIL FENCE
- ⊙ EXISTING UTILITY POLE & GUY WIRE
- ⊙ EXISTING TREES
- ⊙ EXISTING TREE LINE
- ⊙ EXISTING CONTOUR
- ⊙ EXISTING WHITE LINE
- ⊙ EXISTING ROAD CENTERLINE
- ⊙ EXISTING FACE OF BUILDING
- ⊙ LIMIT OF CONSTRUCTION
- ⊙ PROPOSED MAILBOX
- ⊙ PROPOSED DRAINAGE MANHOLE
- ⊙ PROPOSED CB W/STORMWATER PIPE
- ⊙ PROPOSED TREES
- ⊙ PROPOSED TREE LINE
- ⊙ PROPOSED WHITE LINE
- ⊙ PROPOSED ROAD CENTERLINE
- ⊙ PROPOSED PAVEMENT AND BASE
- ⊙ PROPOSED SIDEWALK
- ⊙ PROPOSED JUNCTION BOX, UNDERGROUND ELECTRIC & LIGHT POLE
- ⊙ PROPERTY LINE
- ⊙ SLOPE LIMIT (FILL)
- ⊙ SLOPE LIMIT (CUT)
- ⊙ FINISH GRADE ELEVATION
- ⊙ PROPOSED UTILITY POLE

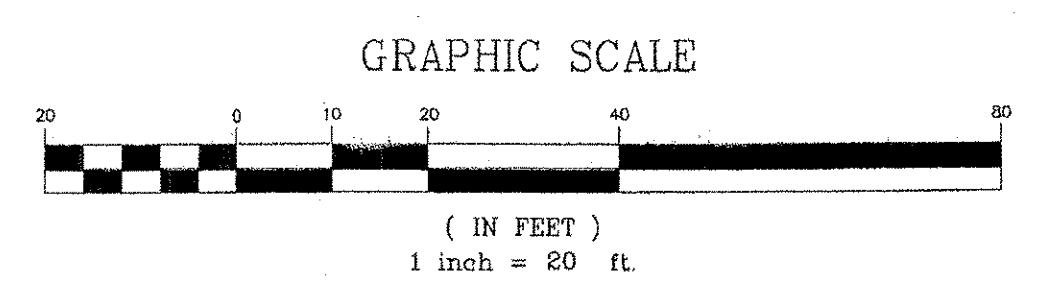

**CENTERLINE DATA**

TO			R	T	L
PC = 0+00	PCC = 0+67.86	41°48'00"	93.03'	35.52'	67.86'
PCC = 0+67.86	PT = 0+76.85	11°29'00"	44.82'	4.51'	8.98'
0+76.85	1+07.15	S50°42'58"E			
1+07.15	2+22.64	S43°40'14"E			
2+22.64	3+72.63	S41°02'19"E			
3+72.63	3+92.16	S44°54'21"E			
3+92.16	4+69.65	S42°03'26"E			
4+69.65	5+87.99	S44°23'37"E			

**NOTE:**  
NEW 6' WIDE CONCRETE SIDEWALK AND GRANITE CURB AND RELATED ITEMS FROM STATION 0+00 TO STATION 1+80 ARE TO BE CONSTRUCTED BY OTHERS.

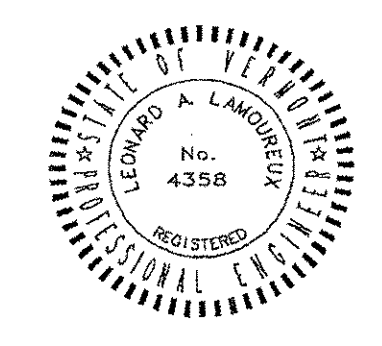

**DATUM**  
VERTICAL NAVD 1988  
HORIZONTAL NAD 1983

REVISIONS

THESE PLANS WITH LATEST REVISIONS SHOULD ONLY BE USED FOR THE PURPOSE SHOWN BELOW.

proj. no.	# OF SHEETS
02-132	

**STP WALK (9)**  
**TOWN OF ESSEX**  
ROUTE 15 IN ESSEX CENTER, VT

**SITE PLAN**  
STATION 0+00 TO 5+75

checked LAL/DLH date 03/01/04 scale 1" = 20' sht. no. 28 ROW SHEET 3 OF 5

**LAMOUREUX & DICKINSON**  
Consulting Engineers, Inc.  
14 Morse Drive  
Essex Junction, VT 05452  
Tel: 802-878-4450