


MATCHLINE STA. 5+75

MATCHLINE STA. 12+25

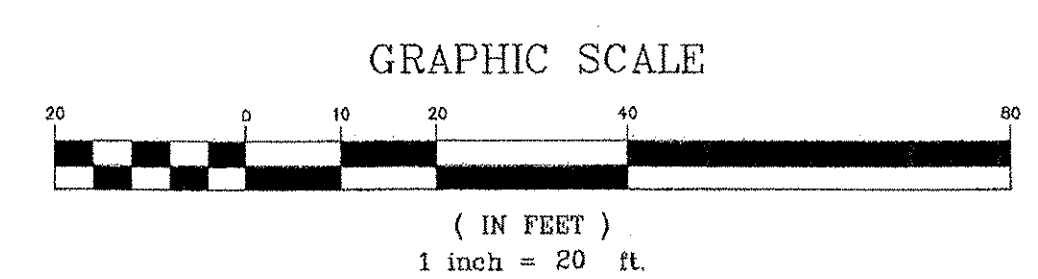

CENTERLINE DATA

TO		Δ
4+69.65	5+87.99	S44°23'37"E
5+87.99	6+01.06	S34°44'28"E
6+01.06	6+11.33	S45°00'00"E
6+11.33	6+26.20	S67°05'17"E
6+26.20	6+50.00	S44°21'48"E
6+50.00	7+01.31	S43°18'58"E
7+01.31	7+51.31	S44°01'41"E
7+51.31	8+26.32	S43°25'26"E
8+26.32	8+40.22	8+40.22
8+40.22	8+74.73	S43°35'32"E
8+74.73	9+29.80	S42°52'08"E
9+29.80	10+21.10	S44°04'32"E
10+21.10	10+88.24	S45°33'36"E
10+88.24	11+87.47	S43°42'05"E
11+87.47	11+99.95	S45°04'20"E
11+99.95	12+49.98	S51°33'35"E

LEGEND

- CONCRETE MONUMENT FOUND
- IRON PIN FOUND
- ☆ EXISTING LIGHT POLE
- ⊕ EXISTING HYDRANT
- ⊙ EXISTING TELEPHONE MANHOLE
- ⊙ EXISTING SEWER MH W/SEWER PIPE
- ⊙ EXISTING MAILBOX
- ⊙ EXISTING CB W/STORMWATER PIPE
- ⊙ EXISTING SIGNS
- ⊙ EXISTING WOOD RAIL FENCE
- ⊙ EXISTING UTILITY POLE & GUY WIRE
- ⊙ EXISTING TREES
- ⊙ EXISTING TREE LINE
- ⊙ EXISTING CONTOUR
- ⊙ EXISTING WHITE LINE
- ⊙ EXISTING ROAD CENTERLINE
- ⊙ EXISTING FACE OF BUILDING
- ⊙ LIMIT OF CONSTRUCTION
- ⊙ PROPOSED MAILBOX
- ⊙ PROPOSED DRAINAGE MANHOLE
- ⊙ PROPOSED CB W/STORMWATER PIPE
- ⊙ PROPOSED TREES
- ⊙ PROPOSED TREE LINE
- ⊙ PROPOSED WHITE LINE
- ⊙ PROPOSED ROAD CENTERLINE
- ⊙ PROPOSED PAVEMENT AND BASE
- ⊙ PROPOSED SIDEWALK
- ⊙ PROPERTY LINE
- ⊙ SLOPE LIMIT (FILL)
- ⊙ SLOPE LIMIT (CUT)
- ⊙ FINISH GRADE ELEVATION
- ⊙ PROPOSED UTILITY POLE



REVISIONS		# OF SHEETS
THESE PLANS WITH LATEST REVISIONS SHOULD ONLY BE USED FOR THE PURPOSE SHOWN BELOW:		02-132
<b>STP WALK (9)</b>		proj. no.
<b>TOWN OF ESSEX</b>		survey
ROUTE 15 IN ESSEX CENTER, VT		&D/OTHER design
<b>SITE PLAN</b>		DLH/LAL drawn
STATION 5+75 TO 12+25		DB checked
		LAL/DLH date
		03/01/04 scale
		1" = 20' sht. no.
		<b>29</b>

DATUM  
VERTICAL NAVD 1988  
HORIZONTAL NAD 1983

**LD** LAMOUREUX & DICKINSON  
Consulting Engineers, Inc.  
14 Morse Drive  
Essex Junction, VT 05452  
Tel. 802-878-4450