




PROJECT NAME: WALLINGFORD
 PROJECT NUMBER: STP ST WALK(14)
 FILE NAME: \$FILES\$
 PROJECT MANAGER: SUSAN SCRIBNER
 DRAWN BY: W. WEATHERBY
 CHECKED BY: P. HALSTEAD
 BRIDGE DESIGN SUPERVISOR: P. HALSTEAD
 SHEET 25 OF 26




RAIL LAYOUT PLAN AND DETAILS

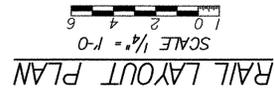

RAIL LAYOUT PLAN

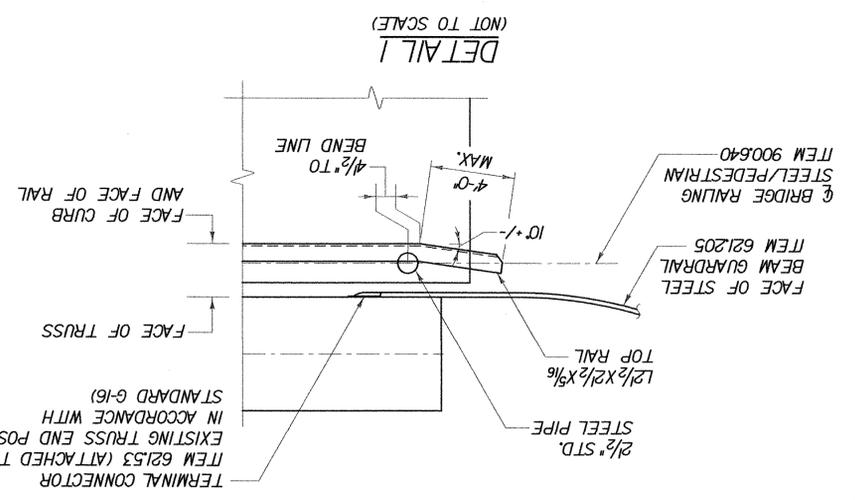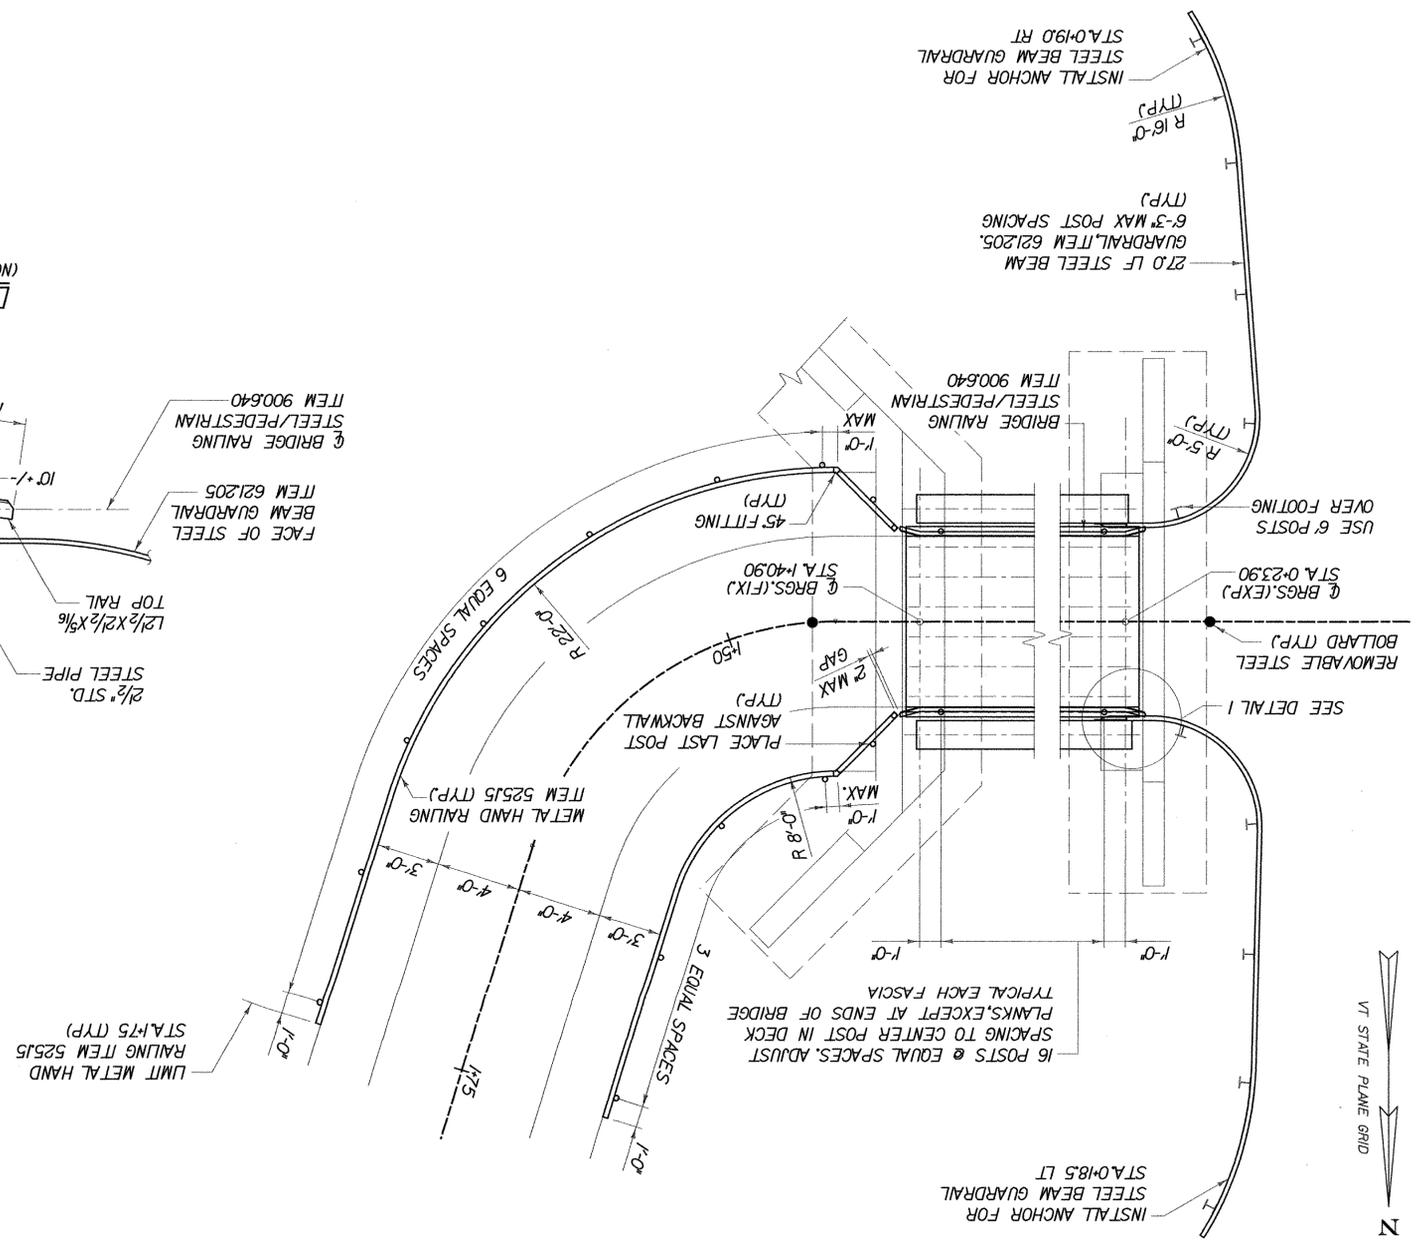

METAL HAND RAILING SECTION
 (NOT TO SCALE)

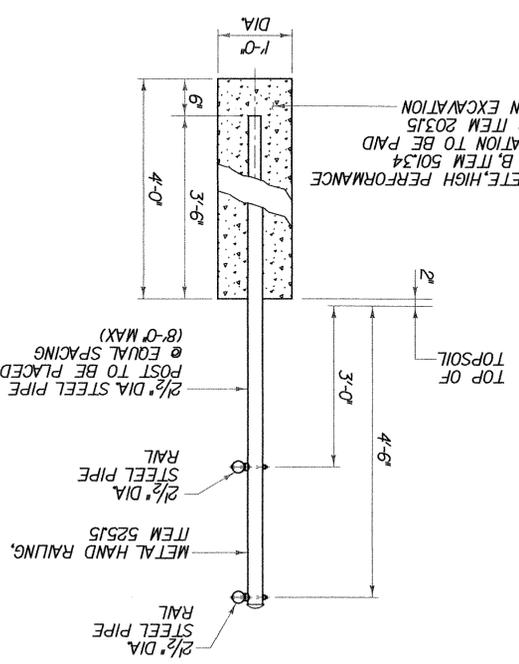

METAL HAND RAILING END ELEVATION
 (NOT TO SCALE)

