


GENERAL NOTES:

- * ALL MEASUREMENTS TO BE VERIFIED BEFORE FABRICATION OF INDIVIDUAL MEMBERS BEGINS
- * ALL HOLES DRILLED IN NEW FABRICATED STEEL, TO MATCH EXISTING STEEL MEMBERS
- * ALL STRUCTURAL STEEL SHALL CONFORM TO AASHTO M-270 GRADE 50
- * UNLESS OTHERWISE NOTED, ALL HOLES SHALL BE DRILLED TO $1\frac{3}{8}$ " DIA
- * DIMENSIONS LESS THAN 25'-0" +/- $\frac{1}{8}$ "
- * DIMENSIONS GREATER THAN 25'-0" +/- $\frac{1}{8}$ "
- * SUPPORTING DOCUMENTATION TO DRAWINGS SEE BILL OF MATERIALS TRUSS TYPE 1 & 2
- * PAINT SYSTEM TO BE USED.
- * ALL PARTS TO BE PRIMED PRIOR TO INSTALLATION.

**NOTE: FOR FUTURE SUBMITTALS
PLEASE PROVIDE BILL OF
MATERIALS, INCLUDING
FASTENERS, ON THE SHEETS
WITH DETAILS.**


BEARING PEDESTAL:

**NOTE: HORIZONTAL LATERAL BRACING /
FLOOR BEAM CONNECTION
PLATES, SCHEDULED FOR
REPLACEMENT AT L0, L2, L4, L6 &
L8 ARE NOT INCLUDED IN THIS
SET.**

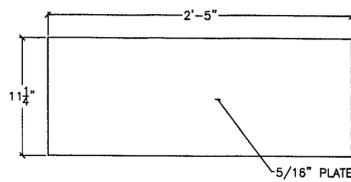


1BP01

3" = 1'-0"

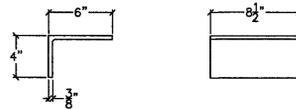

1BP03-ANGLE

3" = 1'-0"

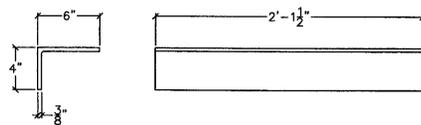

1BP02-ANGLE

3" = 1'-0"



1BP04-ANGLE

3" = 1'-0"

RECEIVED
CK'D BY CHM OK'D BY _____
MAY 11 2009

APPROVED As Noted
BY WY DATE 5/28/09

Revised Elec. Construction
Part 05000 - Steel Decking, VT 0204
(802) 257-7383

TITLE: Wallingford Bridge Rehab
LOCATION: Wallingford, VT

OWNER: VT
DRAWING: Truss Type 1 General Notes & Drawings
DRAWN BY: JED JOB CONTACT: Erick Foster STATE OF VT
CHECKED BY: JED/AD DATE: 4.30.09

DRAWING NO. _____
SHEET NO. T-1
1 of 17