



BEARING PEDESTAL:

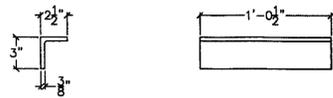



1BP05-ANGLE

3" = 1'-0"

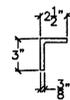

1BP06R-ANGLE

3" = 1'-0"

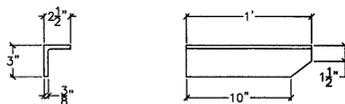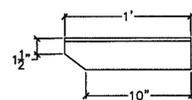

1BP06R-ANGLE

3" = 1'-0"

DIMENSIONS TBD

1BP07-PLATE

3" = 1'-0"

RECEIVED
 OK'D BY CHM OK'D BY _____
 MAY 1 1 2011
 R. G. UNIT _____ APPROVED ✓
 BY WJ DATE 5/1/11

Revised Steel Construction For Vermont State VT 0264 (802) 257-7383	
TITLE: Wallingford Bridge Rehab LOCATION: Wallingford, VT DRAWING TITLE: Drawings Truss Type 1 Drawings DRAWN BY: <u>ED</u> JOB CONTACT: <u>Erick Foster State of VT</u> CHECKED BY: <u>ED/AD</u> DATE: <u>4 30 09</u>	DRAWING NO.: T-1 SHEET NO.: 2 of 17