



BEARING PEDESTAL:

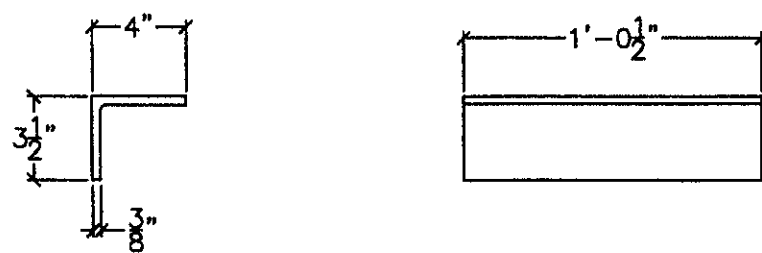

1BA01-ANGLE

3" = 1'-0"

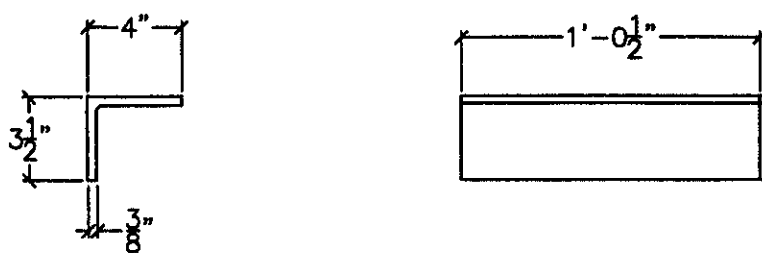

1BA02-ANGLE

3" = 1'-0"

RECEIVED
CK'D BY CWA OK'D BY _____
MAY 11 2017
APPROVED /
BY WJ DATE 5/11/17

Renard Bros Construction Professional Engineer (802) 257-7383	
TITLE Wallingford Bridge Rehab LOCATION Wallingford, VT DRAWING TITLE Drawings Truss Type 1: Drawings DRAWN BY JED JOB CONTACT Erick Foster State of VT CHECKED BY JED/AD DATE 4 30 08	
DRAWING NO.	T-1
SHEET NO.	3 OF 17