



LATTICE:

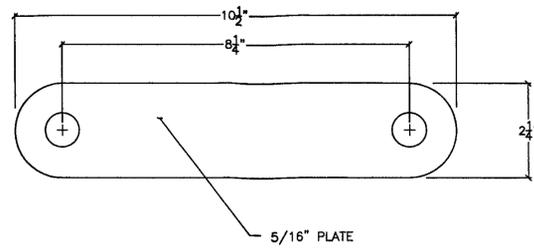

1LP01-PLATE

1'-0" = 1'-0"

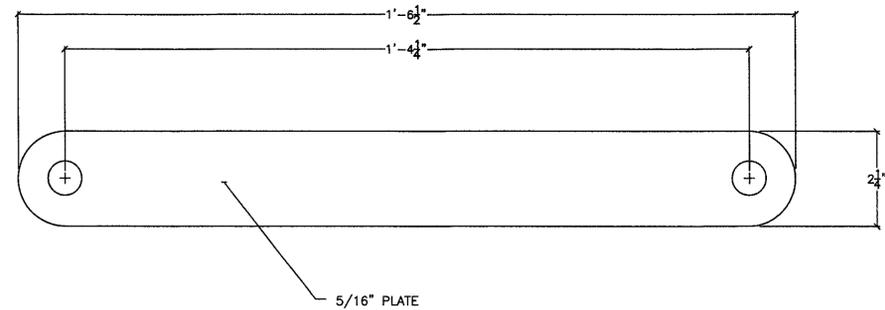

1LP02-PLATE

1'-0" = 1'-0"

RECEIVED
 OK'D BY CWA OK'D BY _____
 MAY 11 2009
 R. C. ... APPROVED
 BY WY DATE 5/11/09

TITLE: Wallingford Bridge Rehab Wallingford, VT DRAWING TITLE: Drawings Truss Type 1 Drawings DRAWN BY: JED CHECKED BY: ED/AD JOB CONTACT: Enck Foster State of VT DATE: 4 30 09	
DRAWING NO.: T-1	SHEET NO.: 4 OF 17