




UPPER CHORD:

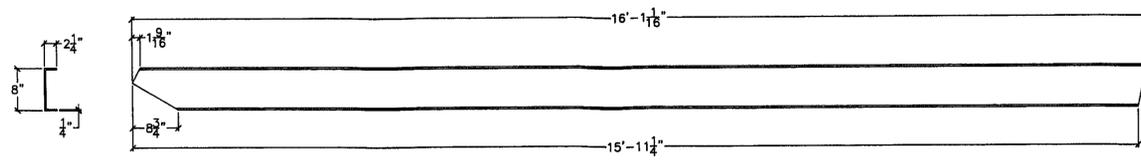

1LOU1-CHANNEL
1-1/2" = 1'-0"

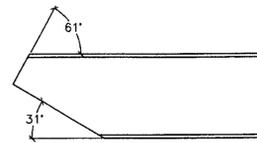

1LOU1-END DETAIL
3" = 1'-0"

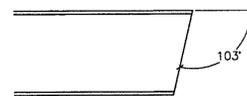

1LOU1-END DETAIL
3" = 1'-0"

RECEIVED
 CK'D BY: CMA OK'D BY: _____
 MAY 11 2010
 BY: WJ/SJ APPROVED: [Signature]
 DATE: 5/11/10

Renewal Base Construction (802) 257-7283	
TITLE: Wallingford Bridge Rehab LOCATION: Wallingford, VT DRAWING TITLE: Drawings Truss Type 1. Drawings DRAWN BY: JED JOB CONTACT: Eric Foster State of VT CHECKED BY: JED/AD DATE: 4 30 09	DRAWING NO: T-1 SHEET NO: 5 of 17