




UPPER CHORD:

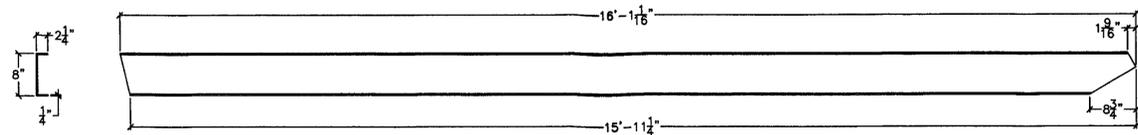

1L8U7-CHANNEL  
1-1/2" = 1'-0"

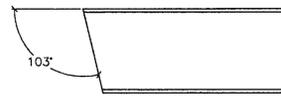

1L8U7-END DETAIL  
3" = 1'-0"

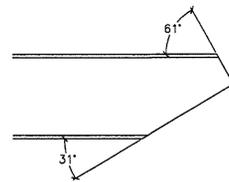

1L8U7-END DETAIL  
3" = 1'-0"

RECEIVED  
MAY 11 2009  
APPROVED ✓  
BY *WJ* DATE 5/12/09

Professional Construction For Engineers and Architects (802) 257-7383	
FILE	Wallingford Bridge Rehab
LOCATION	Wallingford, VT
DRAWING TITLE	Drawings Truss Type 1
DRAWN BY	LED
CHECKED BY	ED/AD
JOB CONTACT	Erick Foster State of VT
DATE	4 30 09
DRAWING NO.	T-1
SHEET NO.	6 OF 17