




UPRIGHT MEMBERS:

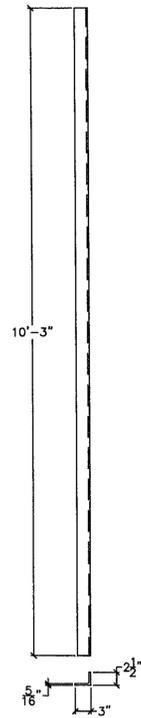

1U2L2L-ANGLE  
1-1/2" = 1'-0"

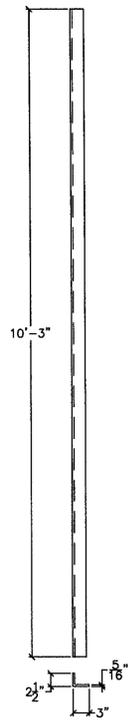

1U2L2R-ANGLE  
1-1/2" = 1'-0"

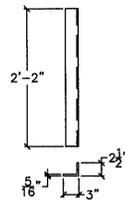

1U3L3L-ANGLE  
1-1/2" = 1'-0"

RECEIVED  
 OK'D BY CWA OK'D BY \_\_\_\_\_  
 MAY 1 1 2009  
 R. J. ... APPROVED ✓  
 BY WY SJ DATE SKALIN

Renew Bros. Construction Renew Bros. Construction (802) 257-7385	
WALLINGFORD BRIDGE REHAB WALLINGFORD, VT	DRAWING TITLE Drawings Truss Type 1 Drawings
DRAWN BY: JED	JOB CONTACT: Ernie Foster State of VT
CHECKED BY: JED/AD	DATE: 4 30 09
DRAWING NO. T-1	SHEET NO. 7 OF 17