




UPRIGHT MEMBERS:

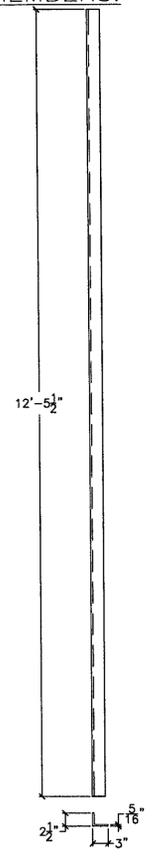

1U3L3R-ANGLE
1-1/2" = 1'-0"

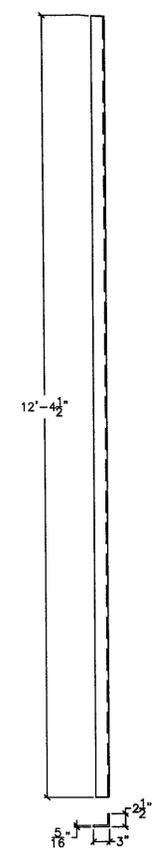

1U4L4L-ANGLE
1-1/2" = 1'-0"

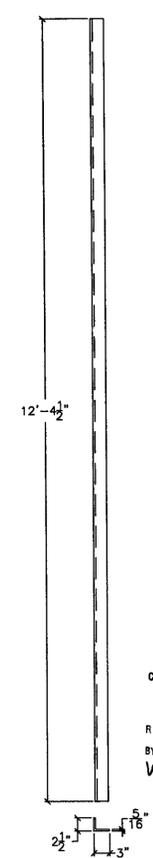

1U4L4R-ANGLE
1-1/2" = 1'-0"

RECEIVED
 CK'D BY: CHA OK'D BY: _____
 MAY 1 12:1
 R. J. ... APPROVED ✓
 BY: WJ DATE: 5/1/09

PREPARED BY: <u>CH</u> CHECKED BY: <u>ED/AD</u> DATE: <u>4 30 09</u>	
TITLE: <u>Wallingford Bridge Rehab</u> LOCATION: <u>Wallingford, VT</u>	DRAWING TITLE: <u>Drawings Truss Type 1 Drawings</u> DRAWN BY: <u>LED</u> JOB CONTACT: <u>Ersk Foster State of VT</u> CHECKED BY: <u>ED/AD</u> DATE: <u>4 30 09</u>
DRAWING NO.	T-1
SHEET NO.	8 of 17

PREPARED BY: CH
 CHECKED BY: ED/AD
 DATE: 4 30 09