



UPRIGHT MEMBERS:

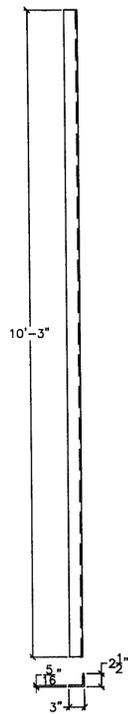

1U6L6L-ANGLE
1-1/2" = 1'-0"

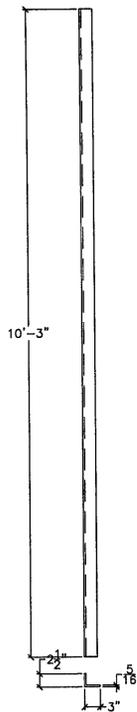

1U6L6R-ANGLE
1-1/2" = 1'-0"

RECEIVED
 OK'D BY CH OK'D BY _____
 MAY 11 2009
 BY WJ DATE 5/11/09

PREPARED BY: Construction (802) 257-7383	
TITLE: Wallingford Bridge Rehab LOCATION: Wallingford, VT	DRAWING NO.: T-1
DRAWING TITLE: Drawings Truss Type 1 Drawings DRAWN BY: JED CHECKED BY: JED/AD	SHEET NO.: 9 of 17
JOB CONTRACT: Erskine Foster State of VT DATE: 4 30 09	