



UPRIGHT MEMBERS:

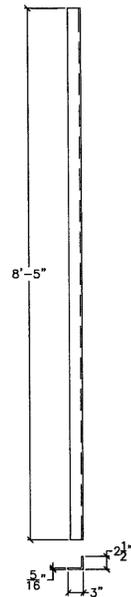

1U7L7L-ANGLE
1-1/2" = 1'-0"

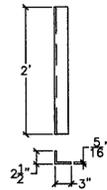

1U7L7R-ANGLE
1-1/2" = 1'-0"

RECEIVED
 OK'D BY CWA OK'D BY _____
 MAY 11 2009
 R BY WJ/SJ APPROVED BY _____
 DATE 5/11/09

Revised Egan Construction (802) 257-7393	
TITLE: Wallingford Bridge Rehab LOCATION: Wallingford, VT	DRAWING TITLE: Drawings Truss Type 1 Drawings DRAWN BY: JED JOB CONTACT: Erik Foster State of VT CHECKED BY: JED/AD DATE: 4 30 09
DRAWING NO.: T-1	SHEET NO.: 10 OF 17