

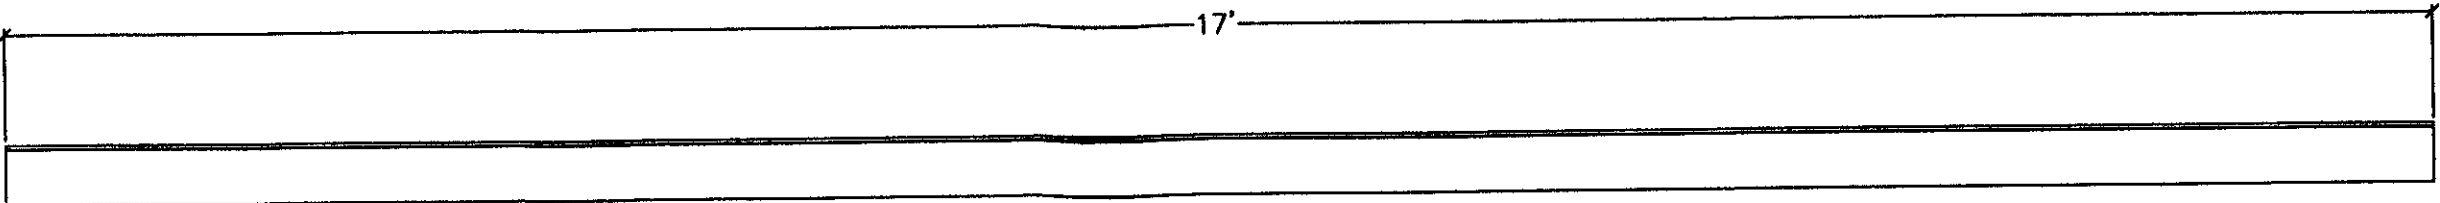
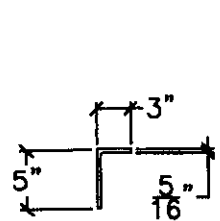




UPRIGHT MEMBERS:

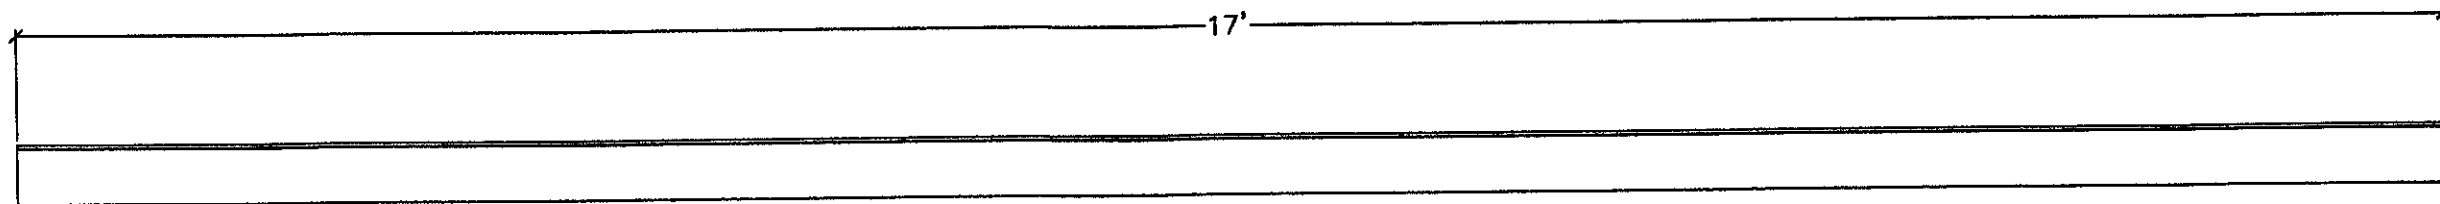

1DM01-ANGLE
1-1/2" = 1'-0"

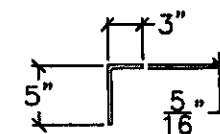

1DM02-ANGLE
1-1/2" = 1'-0"

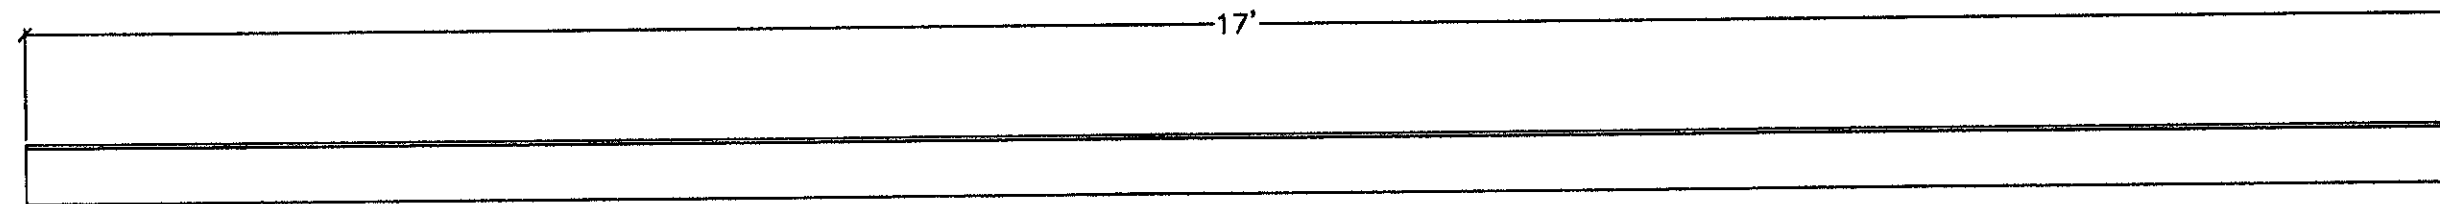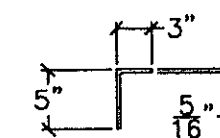

1DM03-ANGLE
1-1/2" = 1'-0"

RECEIVED
CHK'D BY CNA OK'D BY _____
MAY 11 2009
BY WY Sp APP'D [Signature]
DATE 5/11/09

Renard Bros. Construction For Bridgman Road, Vermont VT 05364 (802) 257-7503	
TITLE: Wallingford Bridge Rehab	
LOCATION: Wallingford, VT	DRAWING TITLE: Drawings Truss Type 1
DRAWN BY: JED	JOB CONTACT: Enck Foster State of VT
CHECKED BY: JED/AD	DATE: 4 30 09
DRAWING NO.: T-1	
SHEET NO.: 11 of 17	