

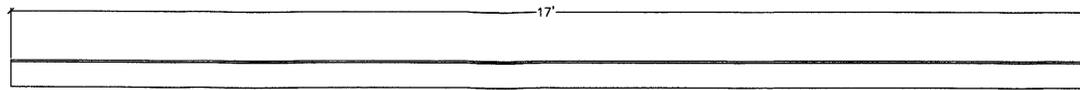


UPRIGHT MEMBERS:

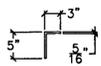

1DM04-ANGLE

1-1/2" = 1'-0"

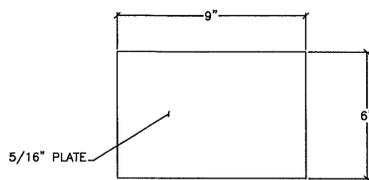

1DM05-PLATE

3" = 1'-0"

- plates similar for U362, U364, U564 and U566

RECEIVED
 OK'D BY RCM OK'D BY _____

MAY 11 2009

BY WJ APPROVED As noted
 DATE 5/11/09

Renew Bros. Construction 1000 W. Main St. (802) 257-7385	
TITLE: Wallingford Bridge Rehab LOCATION: Wallingford, VT	DRAWING TITLE: Drawings Truss Type 1. Drawings DRAWN BY: JED JOB CONTACT: Erick Foster State of VT CHECKED BY: JED/AD DATE: 4.30.09
DRAWING NO.	T-1
SHEET NO.	12 of 17