



BOTTOM CHORD:

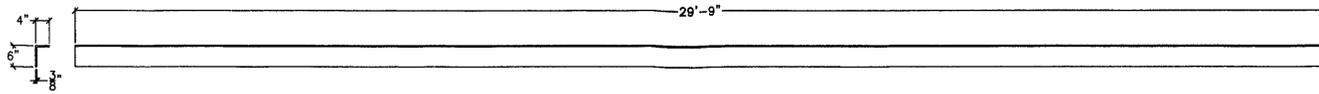


1L2L4A-ANGLE

1" = 1'-0"

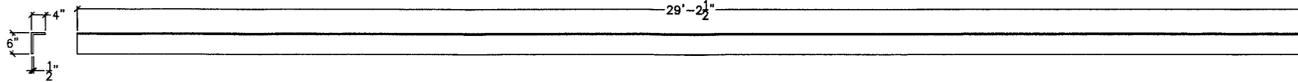

1L2L4A-ANGLE

1" = 1'-0"

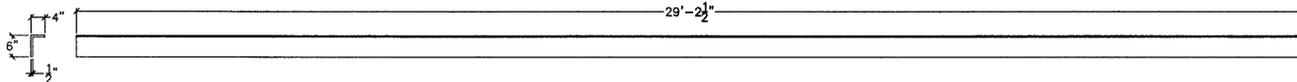

1L2L4B-ANGLE

1" = 1'-0"

RECEIVED  
CHK'D BY CHM OK'D BY \_\_\_\_\_  
MAY 11 2009  
BY WJ DATE 5/20/09

Premier Bros. Construction P.O. Box 100 Wallingford, VT 05491 (802) 257-7383	
Wallingford Bridge Rehab Wallingford, VT	
DRAWING TITLE	Drawings Truss Type 1 Drawings
DRAWN BY	JED
CHECKED BY	JED/JAD
DATE	4 30 09
DRAWING NO.	T-1
SHEET NO.	13 OF 17