



BOTTOM CHORD:

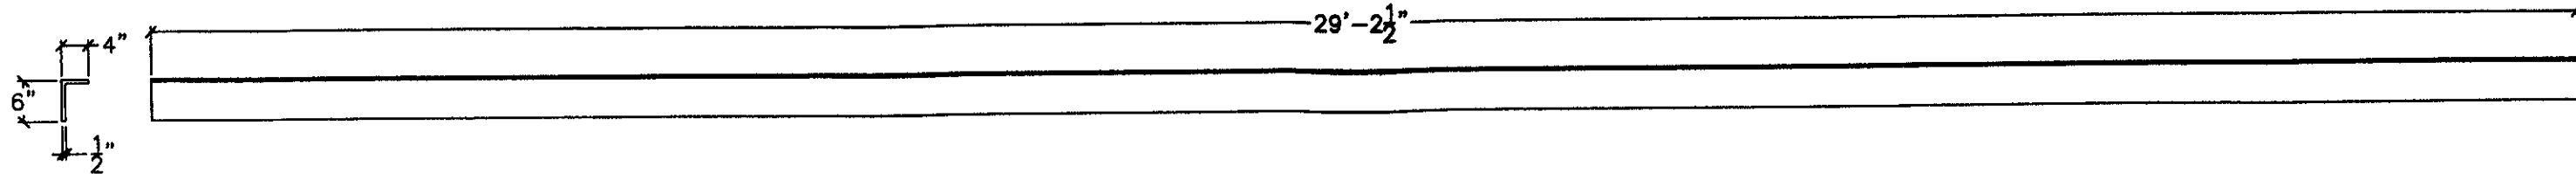

29'-2 1/2"

1L4L6A-ANGLE


1" = 1'-0"

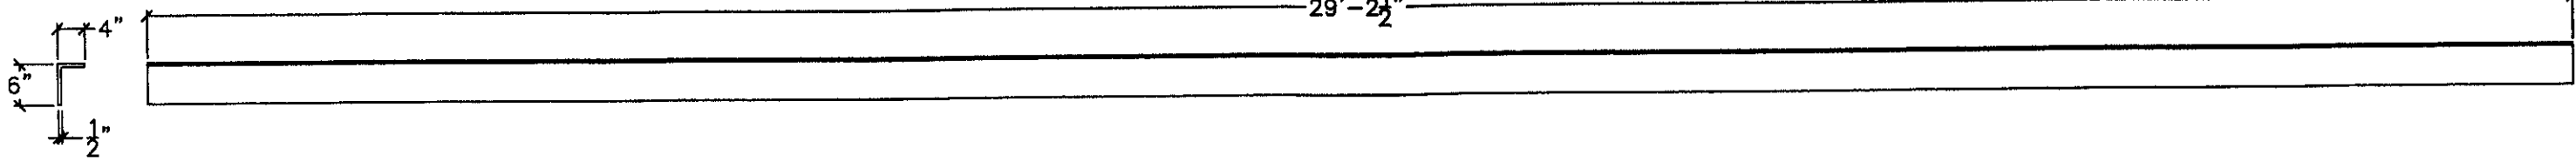

29'-2 1/2"

1L4L6B-ANGLE

1" = 1'-0"

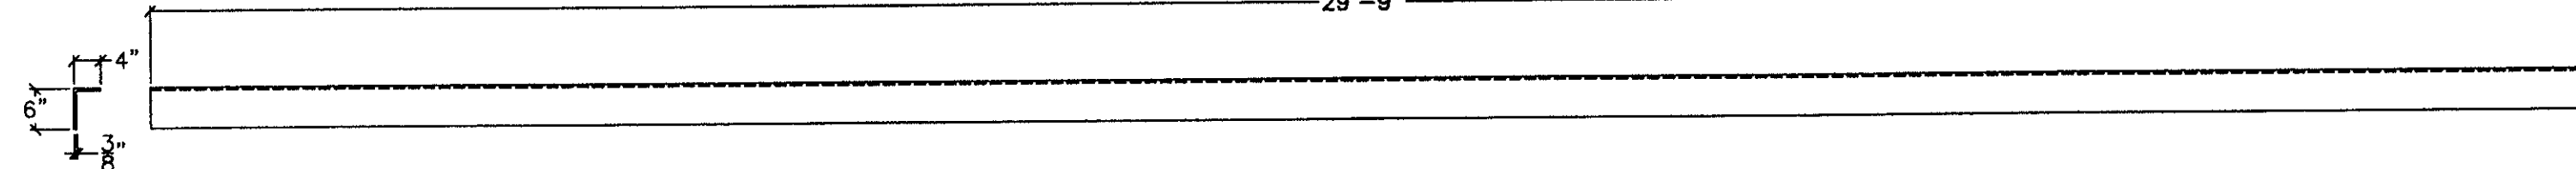

29'-9"

1L6L8A-ANGLE

1" = 1'-0"

RECEIVED
OK'D BY: CWA OK'D BY: _____
MAY 11 2009
BY: WY DATE: 5/11/09

Revised Eng. Construction For Bridge Road Work, VT 05254 (802) 257-7383	
TITLE: Wallingford Bridge Rehab LOCATION: Wallingford, VT	
DRAWING TITLE: Drawings Truss Type 1-	DRAWN BY: JED
CHECKED BY: JED/AD	DATE: 4 30 09
JOB CONTACT: Erik Foster State of VT	
DRAWING NO.	T-1
SHEET NO.	14 of 17