



BOTTOM CHORD:

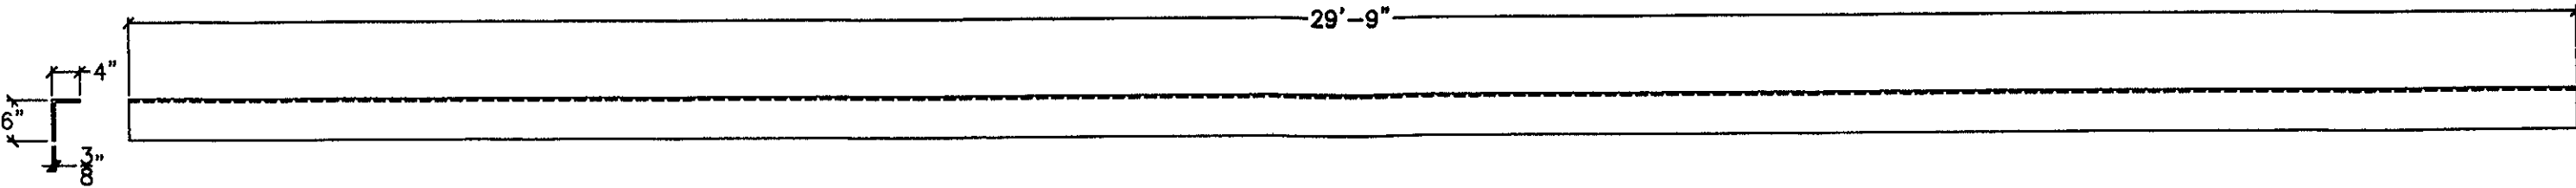

1L6L8B-ANGLE

1" = 1'-0"

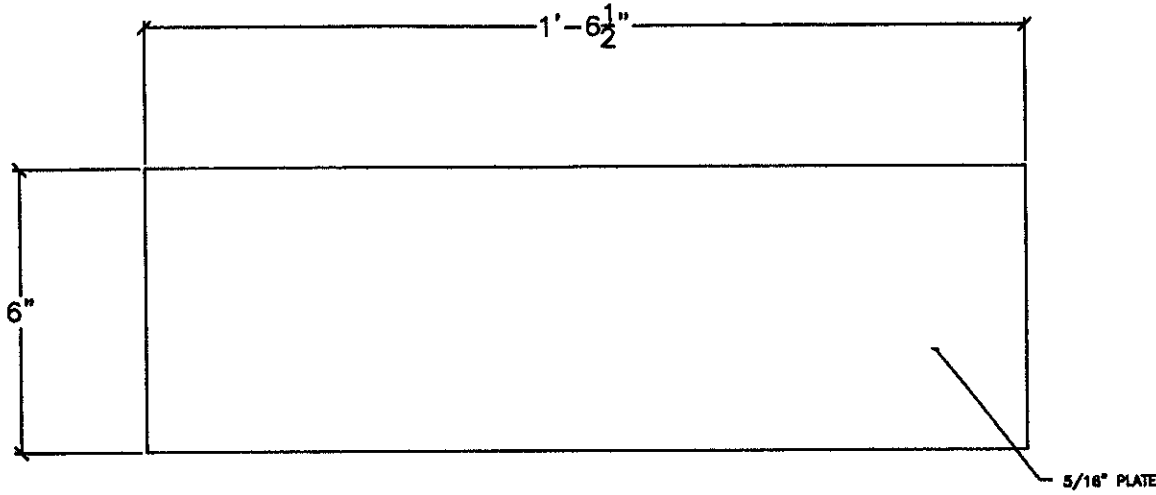

1BC01-PLATE

3" = 1'-0"

RECEIVED
OK'D BY CWA OK'D BY _____

MAY 11 2009

BY WY DATE 5/11/09

Renard Bros. Construction
For Bridge Rep. Vermont, VT 0554
(802) 257-7383

Wallingford Bridge Rehab
Wallingford, VT

DRAWING TITLE

Drawings Truss Type 1 Drawings

DRAWN BY ED JOB CONTACT Erick Foster State of VT

CHECKED BY ED/AD DATE 4 30 09

DRAWING NO.

T-1

SHEET NO.

15 OF 17