




GUSSET PLATES:

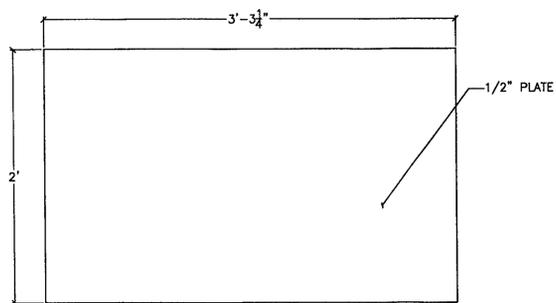

1GP01
3" = 1'-0"

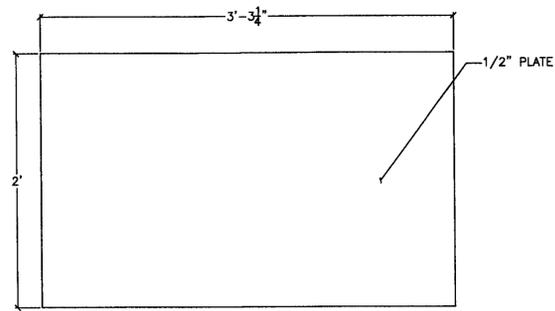

1GP02
3" = 1'-0"

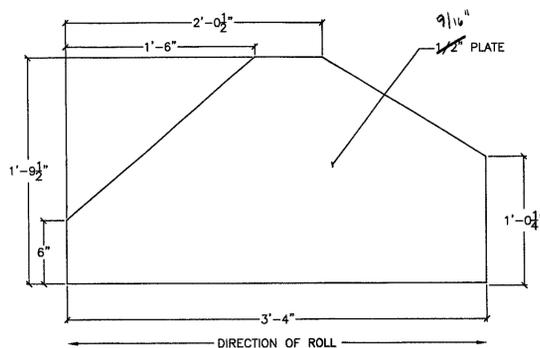

1GP03
3" = 1'-0"

RECEIVED
CHKD BY CWA OK'D BY _____

MAY 11 2009
BY WY DATE 5/11/09

Revised Blue Construction Performance Bond, Inc. VT 0554 (802) 257-7383	
TITLE: <u>Wallingford Bridge Rehab</u> LOCATION: <u>Wallingford, VT</u>	DRAWING TITLE: <u>Drawings Truss Type 1 Drawings</u> DRAWN BY: <u>JED</u> JOB CONTACT: <u>Erick Foster State of VT</u> CHECKED BY: <u>ED/AD</u> DATE: <u>4 30 09</u>
DRAWING NO.	T-1
SHEET NO.	16 OF 17