



GUSSET PLATES:

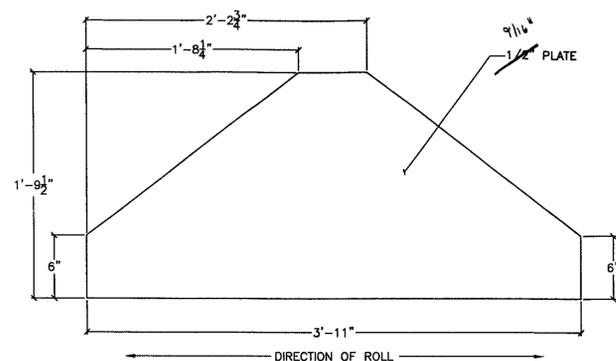

**1GP04**  
3" = 1'-0"

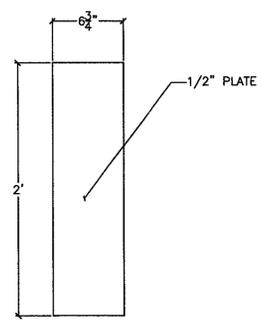

**1GP05**  
3" = 1'-0"

RECEIVED  
 OK'D BY: CHA OK'D BY: \_\_\_\_\_  
 MAY 11 2009  
 BY: WJ APPROVED: As  
 DATE: 5/11/09

Renewal Plus Construction Fort Benjamin Hall Ave., VT 05594 (802) 257-7363	
TITLE: <u>Wallingford Bridge Rehab</u> LOCATION: <u>Wallingford, VT</u>	DRAWING NO.: <u>T-1</u>
SOURCE: <u>Truss Type 1 Drawings</u> DRAWN BY: <u>JED</u> JOB CONTACT: <u>Erick Foster</u> State of VT CHECKED BY: <u>JED/AD</u> DATE: <u>4 30 09</u>	SHEET NO.: <u>17 OF 17</u>