


GENERAL NOTES:


- * ALL MEASUREMENTS TO BE VERIFIED BEFORE FABRICATION OF INDIVIDUAL MEMBERS BEGINS
- * ALL HOLES DRILLED IN NEW FABRICATED STEEL, TO MATCH EXISTING STEEL MEMBERS
- * ALL STRUCTURAL STEEL SHALL CONFORM TO AASHTO M-270 GRADE 50
- * UNLESS OTHERWISE NOTED, ALL HOLES SHALL BE DRILLED TO 1 3/16" DIA
- * DIMENSIONS LESS THAN 25'-0" +/- 1/16"
- * DIMENSIONS GREATER THAN 25'-0" +/- 1/8"
- * SUPPORTING DOCUMENTATION TO DRAWINGS SEE BILL OF MATERIALS TRUSS TYPE 1 & 2.
- * PAINT SYSTEM TO BE USED.

BEARING PEDESTAL:

NOTE: HORIZONTAL LATERAL BRACING / FLOOR BEAM CONNECTION PLATES, SCHEDULED FOR REPLACEMENT AT L0, L2, L4, L6 & L8 ARE NOT INCLUDED IN THIS SET.

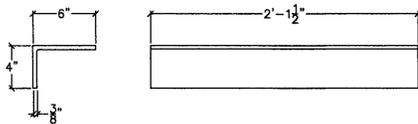

2BP01-ANGLE
3" = 1'-0"

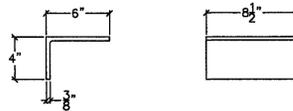

2BP03-ANGLE
3" = 1'-0"

NOTE: FOR FUTURE SUBMITTALS PLEASE PROVIDE BILL OF MATERIALS, INCLUDING FASTENERS, ON THE SHEETS WITH DETAILS.

RECEIVED
 CK'D BY CWA OK'D BY _____
 MAY 11 2009
 RESUBMIT _____ APPROVED As Noted
 BY WY DATE 5/14/09

TITLE: Wallingford Bridge Rehab LOCATION: Wallingford, VT DRAWING TITLE: Drawings Truss Type 2: General Notes & Drawings DRAWN BY: JED CHECKED BY: JED/JAB JOB CONTACT: Erick Foster State of VT DATE: 4 30 09		Renaud Bros Construction Performance Warranty, VT 0504 (802) 251-7888
SHEET NO. T-2		1 of 18