



BEARING PEDESTAL CONT.:

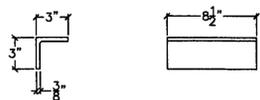


2BP04-ANGLE

3" = 1'-0"

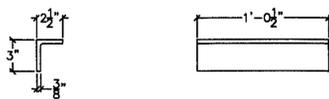


2BP05-ANGLE

3" = 1'-0"

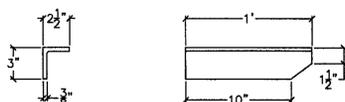

2BP06R-ANGLE

3" = 1'-0"

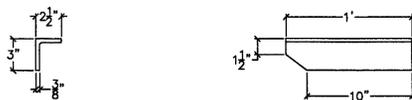

2BP06L-ANGLE

3" = 1'-0"

RECEIVED
 OK'D BY: C.H.B. OK'D BY: _____
 MAY 11 2009
 R. SUEWIT APPROVED As Notd
 BY WJ DATE 5/11/09

| | |
|--|---|
| Revised Eng. Construction Permit (802) 257-7393 | |
| TITLE: Wallingford Bridge Rehab LOCATION: Wallingford, VT | DRAWING TITLE: Drawings Truss Type 2: Drawings DRAWN BY: JED JOB CONTACT: Enck, Foster State of VT CHECKED BY: JED/AD DATE: 4.30.09 |
| DRAWING NO. | T-2 |
| SHEET NO. | 2 OF 18 |