
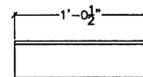


BEARING PEDESTAL CONT.:

TBD WHEN REMOVED
DWG. SUBMITTED FOR
APPROVAL



2BP07-PLATE

3" = 1'-0"

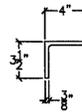

2BA01-ANGLE

3" = 1'-0"

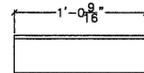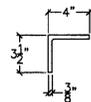

2BA02-ANGLE

3" = 1'-0"

RECEIVED
 CK'D BY CHM OK'D BY _____
 MAY 11 2009
 R-SUE:WIT APPROVED As MTH
 BY SY DATE 5/11/09
WY

FILE LOCATION DRAWING TITLE DRAWN BY CHECKED BY	Wallingford Bridge Rehab Wallingford, VT Drawings Truss Type 2: Drawings JED JED/AD
JOB CONTACT DATE	Erick Foster, State of VT 4 30 09
DRAWING NO. SHEET NO.	T-2 3 of 18

Pinnaud Bros. Construction
 1000 Main Street
 (802) 257-1282