



LATTICE:

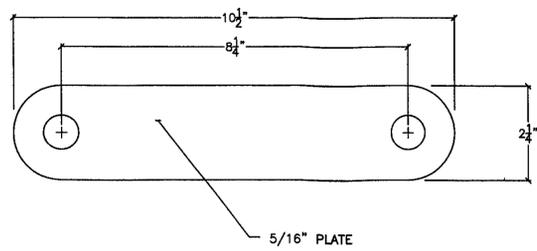

2LP01-PLATE

3" = 1'-0"

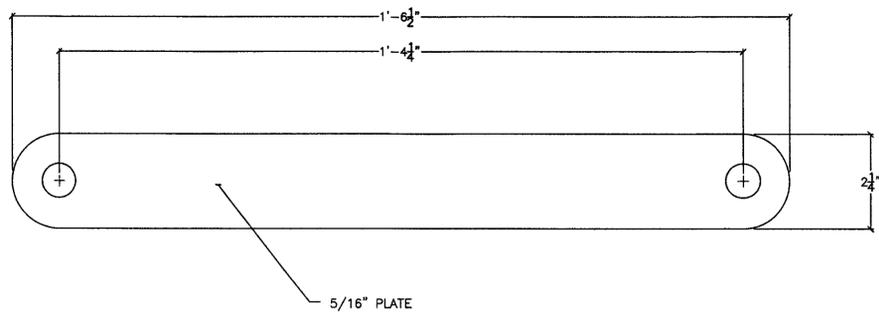

2LP02-ANGLE

3" = 1'-0"

RECEIVED
 CKD BY CA OKD BY _____
 MAY 11 2003
 R SUBMITTED BY WY APPROVED BY As Noted
 DATE 5/11/03

TITLE: Wallingford Bridge Rehab LOCATION: Wallingford, VT DRAWING TITLE: Drawings Truss Type 2: Drawings DRAWN BY: JED CHECKED BY: ED/AD JOB CONTACT: Erik Foster State of VT DATE: 4 30 09	
PREPARED BY: Construction PHONE: (802) 257-7383	DRAWING NO.: SHEET NO.: T-2 4 OF 18