




UPPER CHORD:

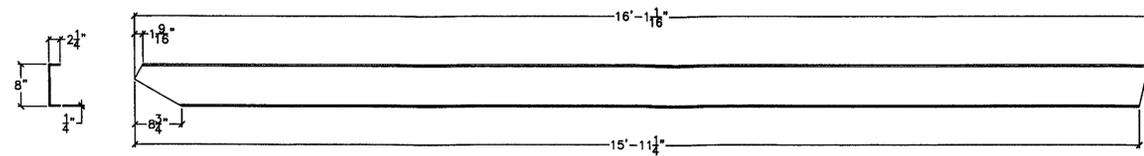

2L8U7-CHANNEL
1-1/2" = 1'-0"

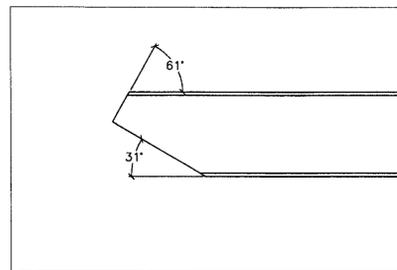

2L8U7-END DETAIL
3" = 1'-0"

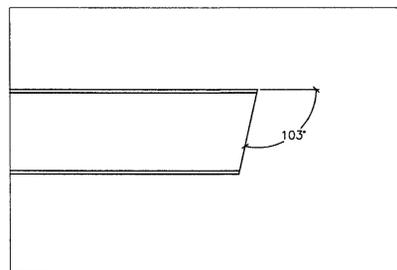

2L8U7-END DETAIL
3" = 1'-0"

RECEIVED
MAY 11 2009
APPROVED BY *[Signature]*
DATE *5/11/09*

FILE	Wallingford Bridge Rehab
LOCATION	Wallingford, VT
DRAWING TITLE	Drawings Truss Type 2 Drawings
DRAWN BY	LED
CHECKED BY	ED/AD
DATE	4 30 09
DRAWING NO.	T-2
SHEET NO.	5 of 18

Renard Bros. Construction
Renard Bros. Road
(802) 257-7385