

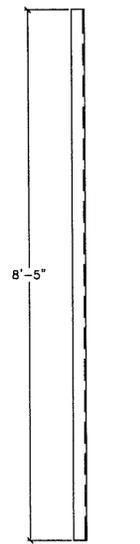




UPRIGHT MEMBERS:

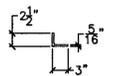

2U1L1L-ANGLE
1-1/2" = 1'-0"

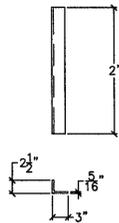

2U1L1R-ANGLE
1-1/2" = 1'-0"

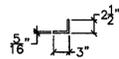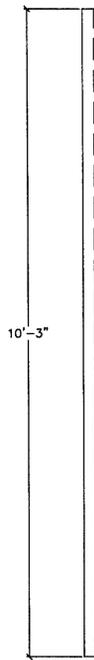

2U2L2L-ANGLE
1-1/2" = 1'-0"

RECEIVED
 MAY 11 2009
 APPROVED *[Signature]*
 BY *[Signature]* DATE *5/11/09*

FILE: Wallingford Bridge Rehab LOCATION: Wallingford, VT DRAWING TITLE: Drawings Truss Type 2 Drawings DRAWN BY: JED CHECKED BY: ED/AD DATE: 4.30.09		Renaud Bros. Construction Renaud Bros. 8804 (802) 257-7185
JOB CONTRACT: Erect Feather State of VT		
DRAWING NO.: T-2		
SHEET NO.: 6 of 18		