

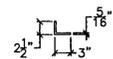
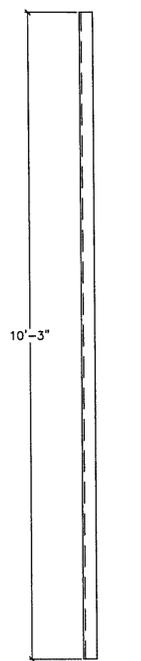




UPRIGHT MEMBERS:

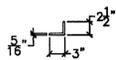

**2U2L2R-ANGLE**  
1-1/2" = 1'-0"

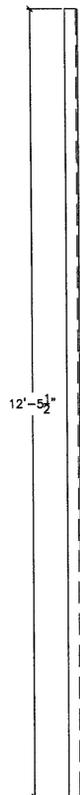

**2U3L3L-ANGLE**  
1-1/2" = 1'-0"

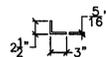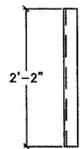

**2U3L3R-ANGLE**  
1-1/2" = 1'-0"

RECEIVED  
 CK'D BY CMB OK'D BY \_\_\_\_\_  
 MAY 11 2009  
 R. J. GILIT APPROVED As Noted  
 BY ag DATE 5/11/09  
WJ

TITLE: Wallingford Bridge Rehab LOCATION: Wallingford, VT DRAWING TITLE: Drawings Truss Type 2- Drawings DRAWN BY: JED JOB CONTACT: Erick Foster State of VT CHECKED BY: ED/AD DATE: 4 30 09		Renewal Eng. Construction 1000 Main Street Wallingford, VT 05488 (802) 257-7253
DRAWING NO.	T-2	
SHEET NO.	7 of 18	