

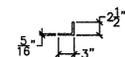
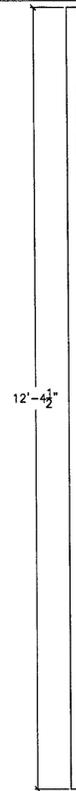




UPRIGHT MEMBERS:

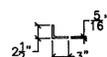

2U4L4L-ANGLE
1-1/2" = 1'-0"

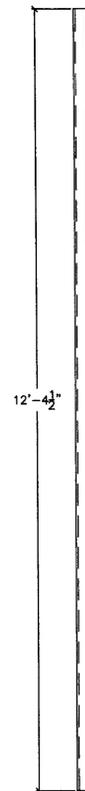

2U4L4R-ANGLE
1-1/2" = 1'-0"

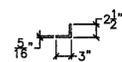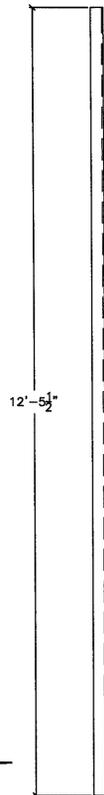

2U5L5L-ANGLE
1-1/2" = 1'-0"

RECEIVED
OK'D BY CHA OK'D BY _____
MAY 11 2009
R. J. C. W. H. T. APPROVED A. M. W.
BY WJ DATE 5/11/09

FILE	Wallingford Bridge Rehab
LOCATION	Wallingford, VT
DRAWING TITLE	Drawings Truss Type 2: Drawings
DRAWN BY	LED
CHECKED BY	ED/AD
DATE	4 30 09
JOB CONTACT	Erick Foster State of VT
REINOLD BROS. CONSTRUCTION REINOLD BROS. CONSTRUCTION 1000 W. MAIN ST. WALLINGFORD, VT 05793 (802) 257-7385	
DRAWING NO.	T-2
SHEET NO.	8 of 18