



UPRIGHT MEMBERS:

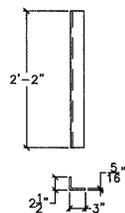


**2U5L5R-ANGLE**  
1-1/2" = 1'-0"

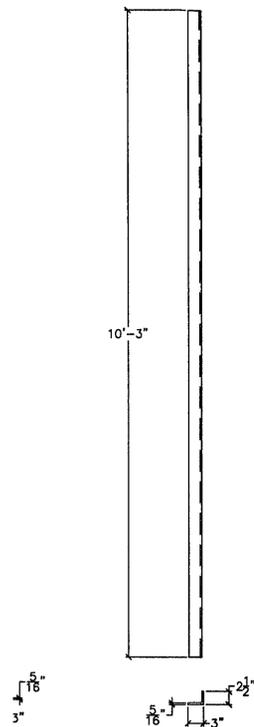

**2U6L6L-ANGLE**  
1-1/2" = 1'-0"

**RECEIVED**  
 OK'D BY CHA OK'D BY \_\_\_\_\_  
 MAY 11 2009  
 REVIEWED BY \_\_\_\_\_ APPROVED A.M.H.  
 BY WJ DATE 5/11/09

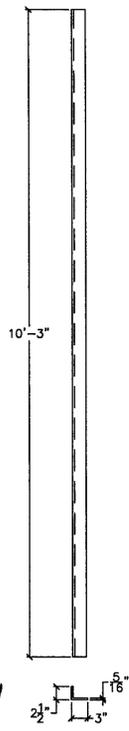

**2U6L6R-ANGLE**  
1-1/2" = 1'-0"

TITLE: Wallingford Bridge Rehab LOCATION: Wallingford, VT DRAWING TITLE: Drawings Truss Type 2: Drawings DRAWN BY: JED CHECKED BY: JED/AD DATE: 4 30 09	Renaud Bros. Construction Renaud Bros. Construction (802) 257-7285
SHEET NO.: T-2 9 of 18	