

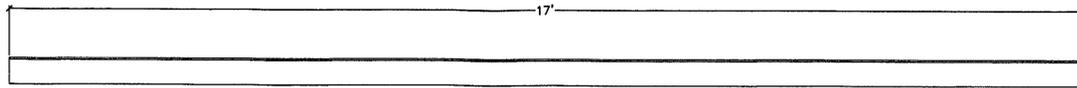
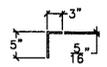


UPRIGHT MEMBERS:

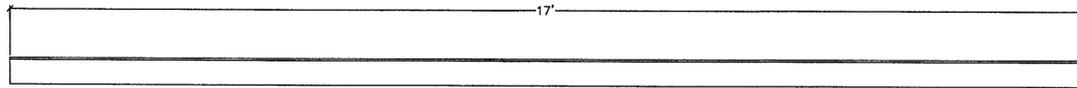

2DMO1-ANGLE  
 $1-1/2" = 1'-0"$

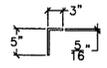

2DMO2-ANGLE  
 $1-1/2" = 1'-0"$

RECEIVED  
 CK'D BY CHA OK'D BY \_\_\_\_\_  
 MAY 11 2009  
 R. JENIT APPROVED As Noted  
 BY WY DATE 5/11/09

Renaud Bros. Construction Performance, VT 056 (802) 257-1200	
TITLE: Wallingford Bridge Rehab LOCATION: Wallingford, VT	DRAWING TITLE: Drawings Truss Type 2 Drawings DRAWN BY: JED CHECKED BY: JED/AD
JOB CONTACT: Erick Foster State of VT DATE: 4.30.09	SHEET NO.: T-2 10 of 18