

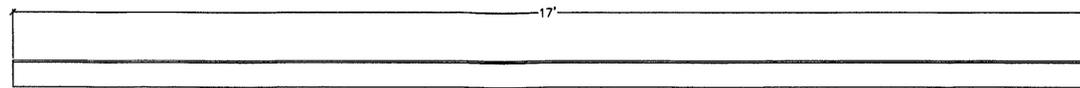
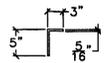


UPRIGHT MEMBERS:

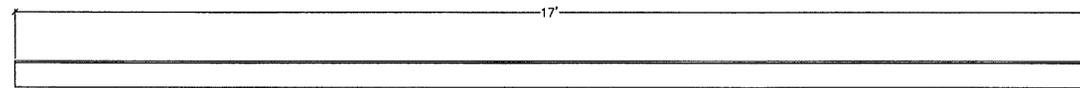

2DMO3-ANGLE  
 $1-1/2'' = 1'-0''$

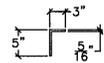

2DMO4-ANGLE  
 $1-1/2'' = 1'-0''$

RECEIVED  
 OK'D BY CHA OK'D BY \_\_\_\_\_

MAY 11 2009

APPROVED As  
 BY WJ DATE 5/14/09

FILE	Wallingford Bridge Rehab
LOCATION	Wallingford, VT
DRAWING TITLE	Drawings Truss Type 2: Drawings
DRAWN BY	JED
CHECKED BY	JED/AD
JOB CONTACT	Erick Foster State of VT
DATE	4 30 09
DRAWING NO.	T-2
SHEET NO.	11 of 18

Renard Bros. Construction  
 1000 Main Street  
 (802) 257-7385