


UPRIGHT MEMBERS:

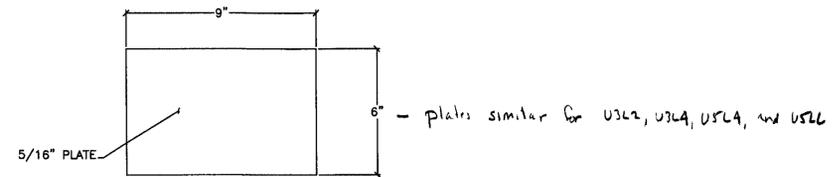

2DM05-PLATE  
6" = 1'-0"

RECEIVED  
OK'D BY CMA OK'D BY \_\_\_\_\_

MAY 11 2009  
APPROVED As Noted  
BY SJA DATE 5/11/09  
WY

FILE	Wallingford Bridge Rehab
LOCATION	Wallingford, VT
DRAWING TITLE	Drawings Truss Type 2. Drawings
DRAWN BY	JED
CHECKED BY	JED/AD
JOB CONTACT	Ersk Forter State of VT
DATE	4 30 09

Revised Bros Construction  
Rt 100 Wallingford VT  
(802) 257-7383

DRAWING NO. T-2

SHEET NO. 12 OF 18