




BOTTOM CHORD:

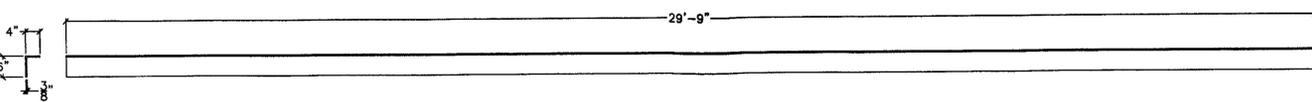

2L9'-9" - ANGLE  
1" = 1'-0"

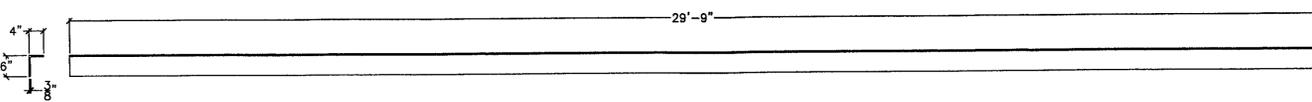

2L9'-9" - ANGLE  
1" = 1'-0"

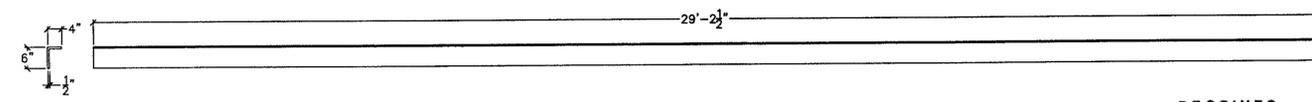

2L29'-2 1/2" - ANGLE  
1" = 1'-0"

**RECEIVED**  
 OK'D BY: CLH OK'D BY: \_\_\_\_\_  
 MAY 11 2009  
 R. J. LEWIS APPROVED By [Signature]  
 BY: SJS DATE: 5/12/09  
 WJ

PERMANENT BRIDGE CONSTRUCTION 1000 W. MAIN ST. FERRISBURGH, VT 05753 (802) 257-7353	
TITLE: <u>Wallingford Bridge Rehab</u> LOCATION: <u>Wallingford, VT</u>	DRAWING NO.: <u>T-2</u>
DRAWING TITLE: <u>Drawings Truss Type 2 Drawings</u> DRAWN BY: <u>ED</u> JOB CONTACT: <u>Erick Foster State of VT</u> CHECKED BY: <u>SED/AD</u> DATE: <u>4-30-09</u>	SHEET NO.: <u>13 of 18</u>