



BOTTOM CHORD:

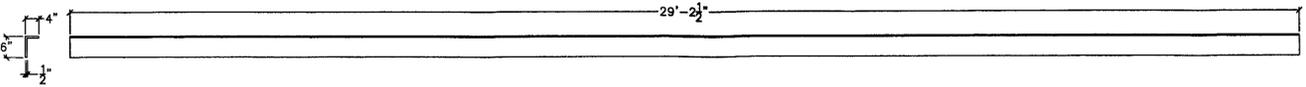

2L4L6A-ANGLE

1" = 1'-0"

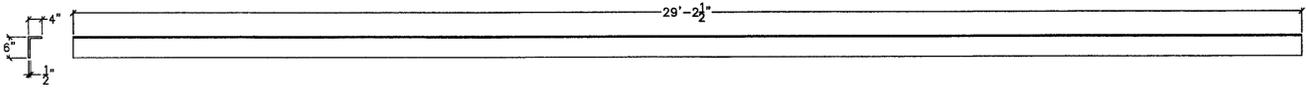

2L4L6B-ANGLE

1" = 1'-0"

RECEIVED
CK'D BY CLM OK'D BY _____

MAY 11 2011
APPROVED As Nihil
BY WY DATE 5/11/11

FILE	Wallingford Bridge Rehab
LOCATION	Wallingford, VT
DRAWING TITLE	Drawings Truss Type 2: Drawings
DRAWN BY	JED
CHECKED BY	ED/AD
DATE	4 30 09
JOB CONTACT	Erick Foster State of VT
PREPARED BY	CONSTRUCTION SERVICES (802) 257-7393

DRAWING NO. T-2
SHEET NO. 14 OF 18