


BOTTOM CHORD:

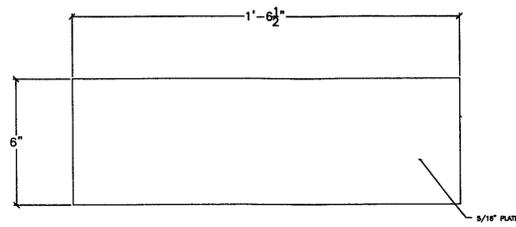

2BC01-PLATE

3" = 1'-0"

RECEIVED
CK'D BY CHE OK'D BY _____
MAY 11 2009
RESUBMIT _____ APPROVED As Noted
BY WY DATE 5/11/09

FILE	Wallingford Bridge Rehab
LOCATION	Wallingford, VT
DRAWING TITLE	Drawings Truss Type 2- Drawings
DRAWN BY	JED
CHECKED BY	JED/AD
DATE	4 30 08
JOB CONTACT	Erick Foster State of VT
DRAWING NO.	T-2
SHEET NO.	16 OF 18

Permaid Bros. Construction
Rural Route 1
Wallingford, VT 05783
(802) 257-7353