




GUSSET PLATES.:

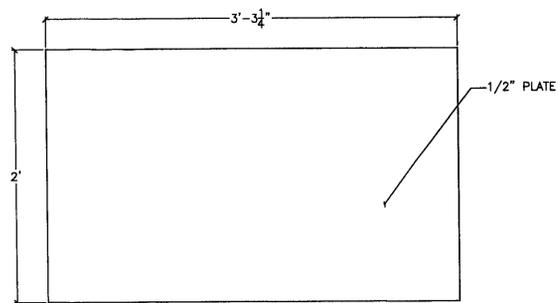

2GP01-PLATE
3" = 1'-0"

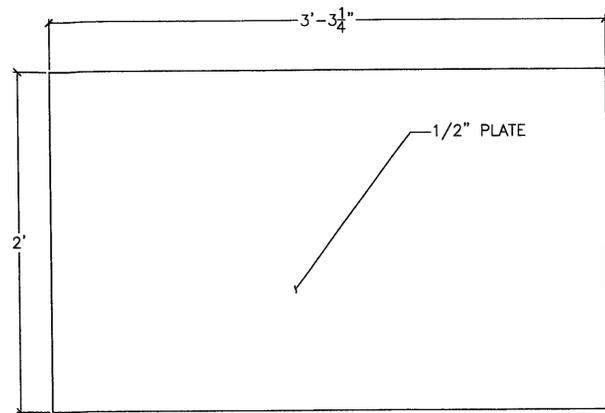

2GP02-PLATE
3" = 1'-0"

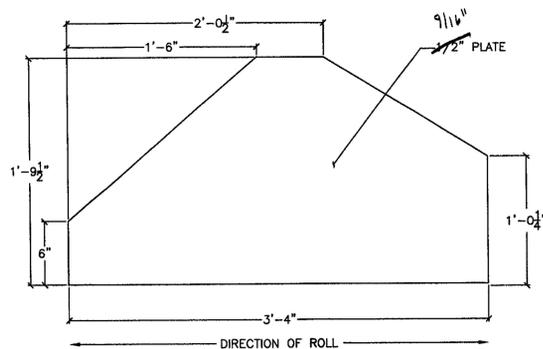

2GP03-PLATE
3" = 1'-0"

RECEIVED
 CK'D BY Chh OK'D BY _____
 MAY 11 2009
 R/SUBMIT _____ APPROVED As NW
 BY WY DATE sh/14

PERIODIC BRIDGE CONSTRUCTION WALLINGFORD, VT (802) 257-7353	
TITLE Wallingford Bridge Rehab Wallingford, VT	DRAWING TITLE Drawings Truss Type 2 Drawings
DRAWN BY: <u>JED</u>	JOB CONTACT: <u>Erick Foster State of VT</u>
CHECKED BY: <u>JED/AD</u>	DATE: <u>4 30 09</u>
DRAWING NO. <u>T-2</u>	SHEET NO. 17 of 18