



GUSSET PLATES.:

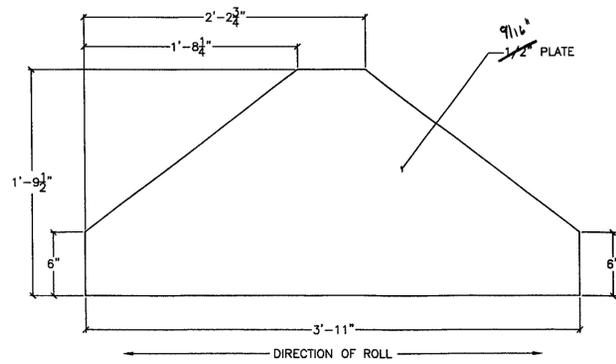

2GP04-PLATE
3" = 1'-0"

RECEIVED
 CK'D BY CM OK'D BY _____
 MAY 11 2009
 RF SUEMIT _____ APPROVED As Noted
 BY WY DATE 5/11/09

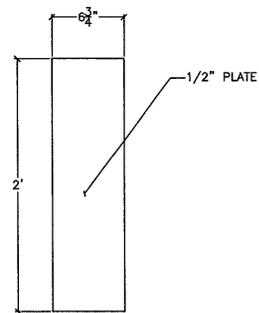

2GP05-PLATE
3" = 1'-0"

Renard Bros. Construction Rt. 1, Wallingford, VT 05491 (802) 257-1285	
TITLE	Wallingford Bridge Rehab
LOCATION	Wallingford, VT
DRAWING TITLE	Drawings Truss Type 2 Drawings
DRAWN BY	JED
CHECKED BY	ED/AD
JOB CONTACT	Erick Foster State of VT
DATE	4.30.09
DRAWING NO.	T-2
SHEET NO.	18 of 18