


8 HORIZONTAL BRACES HB1

SHOP NOTE
TOE DIRECTION NEAR SIDE
LONG LEG SHOWN


DATE 6/3/09 BY [Signature]

CLDIGH HARBOUR & ASSOCIATES LLP
ENGINEERS ARCHITECTS
& LANDSCAPE ARCHITECTS

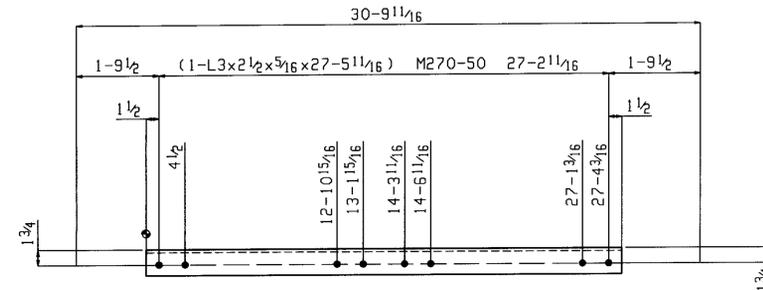


4 HORIZONTAL BRACES HB2


SHOP NOTE:
TOE DIRECTION FAR SIDE
LONG LEG SHOWN

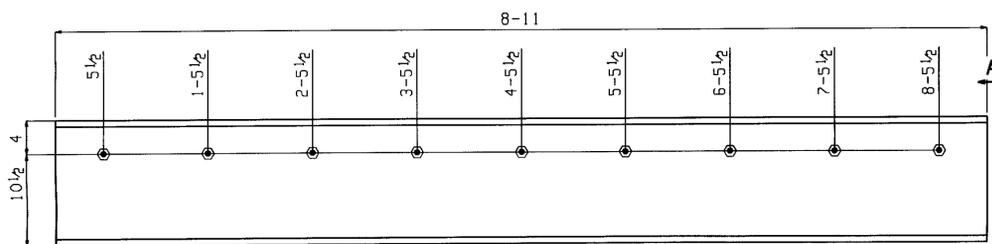


ONE MISC M1
GALV

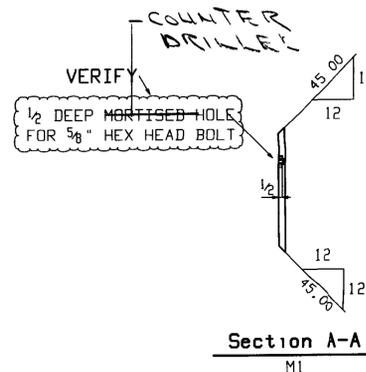

Section A-A
M1

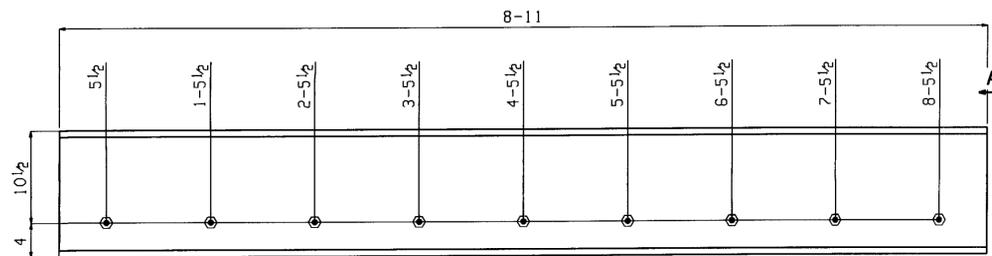

ONE MISC M2
GALV

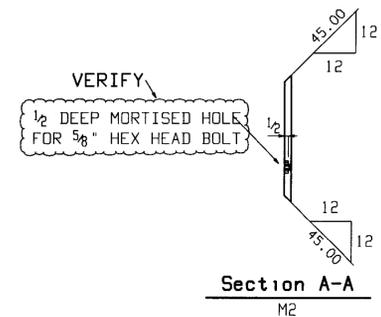

Section A-A
M2

BILL OF MATERIAL										BILL OF MATERIAL										BILL OF MATERIAL									
Qty	Piece									Qty	Piece									Qty	Piece								
Tot.	Mark	Description	Length	Seq. NO.	Seq. Qty	Adv. ABM #	Steel Grade	Remarks		Tot.	Mark	Description	Length	Seq. NO.	Seq. Qty	Adv. ABM #	Steel Grade	Remarks		Tot.	Mark	Description	Length	Seq. NO.	Seq. Qty	Adv. ABM #	Steel Grade	Remarks	
8		HORIZONTAL BRACE		1	8					1	M1	MISC	8'-11"	1	1		M270-50	GALV											
8	HB1	L3x2 1/2 x 3/16	13'-3 3/16"				M270-50																						
4		HORIZONTAL BRACE		1	4					1	M2	MISC	8'-11"	1	1			GALV											
4	HB2	L3x2 1/2 x 3/16	27'-5 11/16"				M270-50																						

Total weight 1832

RECEIVED
 OCT BY _____ OK'D BY _____
 MAY 26 2003
 RF-SUBMIT _____ APPROVED _____
 BY _____ DATE _____

Renaud Bros. Inc.
 283 Fort Bridgeman Rd. #2
 Vernon, VT. 05354
 Phone 1-802 257-7383

Rev. No: _____ Date: _____
 Project: **WALLINGFORD BRIDGE** Date: 4-28-09 Job No. _____
 WALLINGFORD, VT. DWN. BY EG Checked: _____ Sheet No. HB1-2, M1-2

Holes: 13/16 UNF
 BOLTS: 3/4" DIA M164-I GALV
 Steel GR: M270-50 UNF
 Paint: PER SPECS
 Surface Prep: PER SPECS

MAY 15 2003 03:03:51 PM