


1-1-1, 1-1-2, 1-1-3, 1-1-4, 1-1-5, 1-1-6 = 1-1-1 x 1/2
 (SUBMIT TOY OF 1-1-1 x 1/2 ANGLE PER 4-2-10, PER TO SPEC)

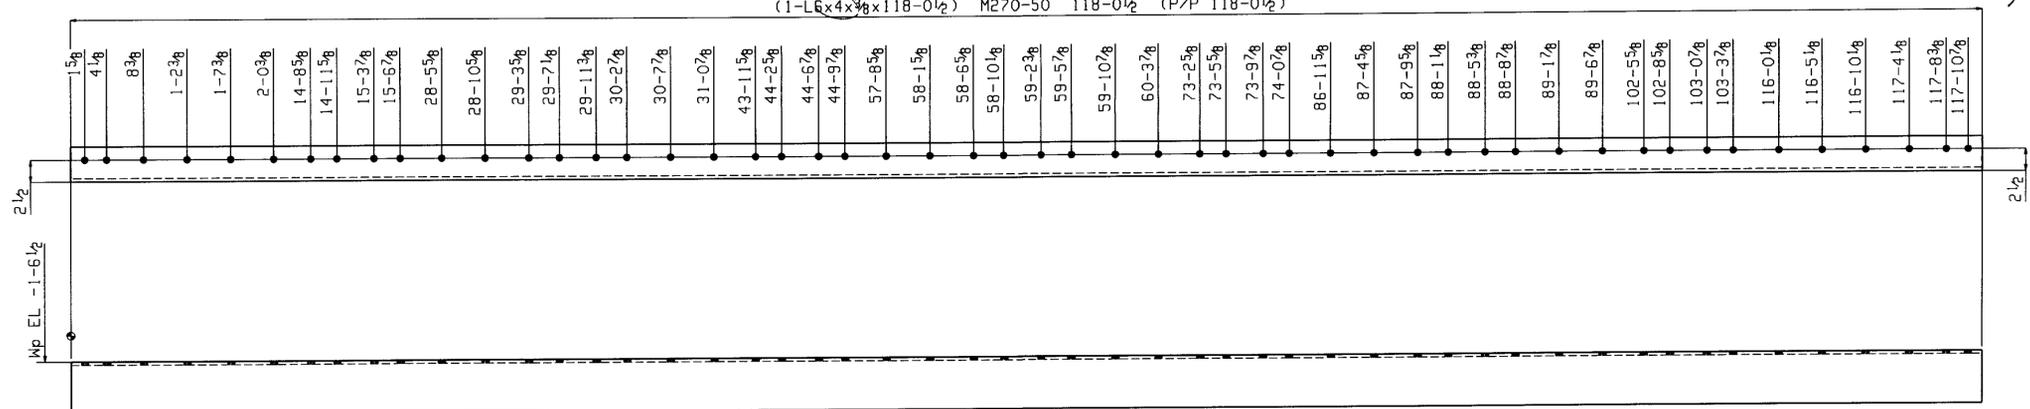

ONE MISC M3


SHOP NOTE:
TOE DIRECTION FAR SIDE

NO EXCEPTION TAKEN MAKE CORRECTIONS NOTED
 REJECTED REVISE AND RESUBMIT
 SUBMIT SPECIFIED ITEMS

THIS DRAWING IS ONLY VALID FOR THE PROJECT AND SITE SPECIFIC TO THE PROJECT. IT IS NOT TO BE USED FOR ANY OTHER PROJECTS. THE CONTRACTOR SHALL BE RESPONSIBLE FOR VERIFYING THE ACCURACY OF ALL DIMENSIONS AND THE PERFORMANCE OF ALL OTHER MATERIALS AND THE FACTORY PERFORMANCE OF ALL MATERIALS.

CLOUGH HARDEN & ASSOCIATES LLP
 ENGINEERS - ARCHITECTS - INTERIORS
 & GENERAL CONTRACTORS

DATE 6/19/09 BY [Signature]

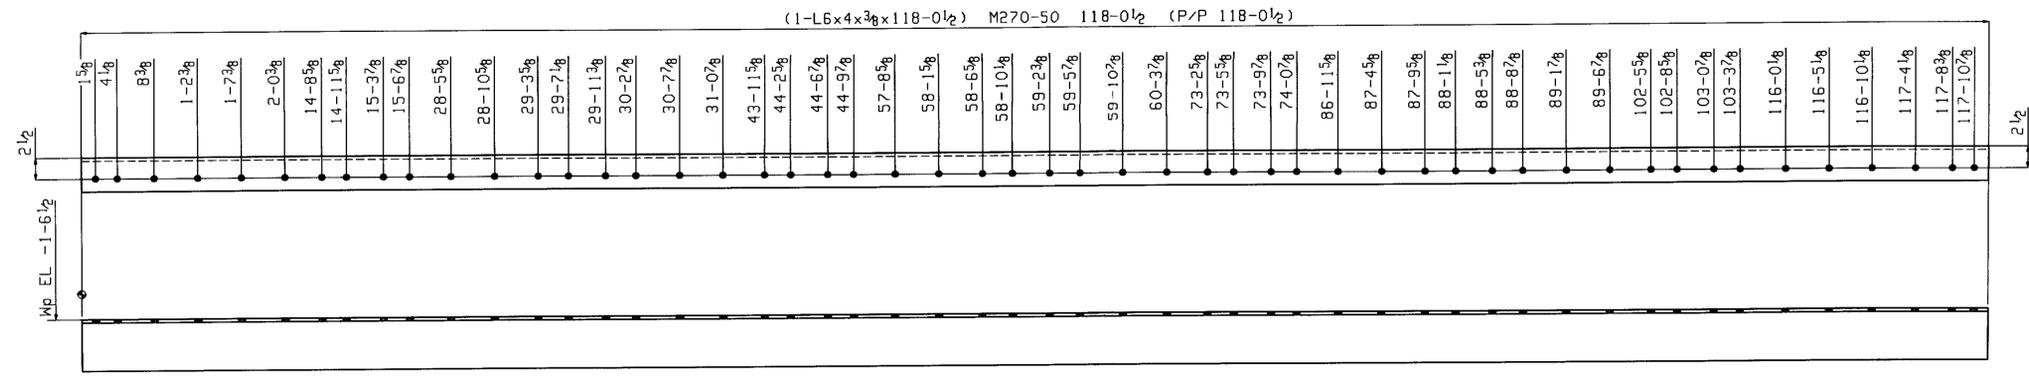

ONE MISC M4

SHOP NOTE:
TOE DIRECTION NEAR SIDE

BILL OF MATERIAL										BILL OF MATERIAL										BILL OF MATERIAL									
Qty	Piece				Seq	Seq	Adv	Steel	Remarks	Qty	Piece				Seq	Seq	Adv	Steel	Remarks	Qty	Piece				Seq	Seq	Adv	Steel	Remarks
Tot.	Mark	Description	Length		NO.	Qty	ABM #	Grade		Tot.	Mark	Description	Length		NO.	Qty	ABM #	Grade		Tot.	Mark	Description	Length		NO.	Qty	ABM #	Grade	
ONE		MISC			1	1																							
1	M3	L6x4x3/8	118	0 1/2				M270-50																					
ONE		MISC			1	1																							
1	M4	L6x4x3/8	118	0 1/2				M270-50																					

Total weight 2888

RECEIVED
 CND BY _____
 MAY 26 2009
 RFSUBMIT _____
 APPROVED _____
 BY _____ DATE _____

Renaud Bros. Inc.
 283 Fort Bridgeman Rd. #2
 Vernon, VT. 05354
 Phone 1-802 257-7383

Holes: 1 3/16 UNF
 BOLTS: 3/4" DIA M164-I GALV
 Steel GR: M270-50 UNF
 Paint: PER SPECS
 Surface Prep: PER SPECS

Rev.No: _____ Date: 4-28-09 Job No. _____
 DWN. BY: EG Checked Sheet No. M3, 4

MAY 15 2009 05:05:54 PM