



RAILING SYSTEM:




WASHER SELECTION  
6"=1'-0" QTY 240

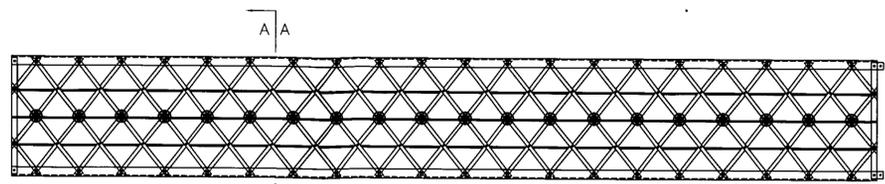


RAIL ASSEMBLY ELEV  
1"=1'-0"

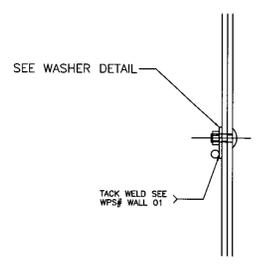


DETAIL A  
6"=1'-0"

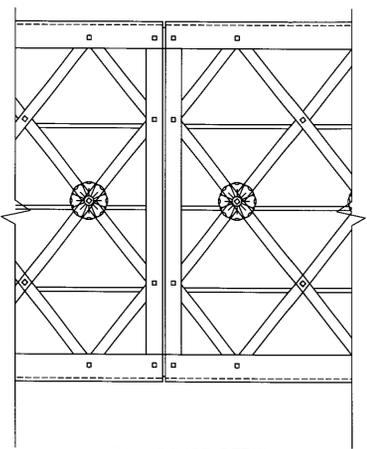

RAIL SPLICE DETAIL  
3"=1'-0"

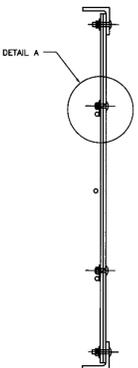

SECTION A-A  
3"=1'-0"

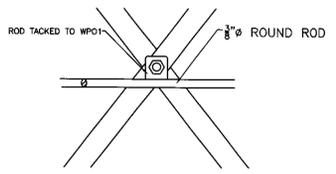

WASHER DETAIL  
6"=1'-0"

RECEIVED  
CHKD BY \_\_\_\_\_ OK'D BY \_\_\_\_\_  
JUL 31 2004  
APPROVED \_\_\_\_\_  
BY *W.B. Sp* DATE *8/4/04*

Pennaud Bros. Construction 1000 Main Street Wallingford, VT 05491 (802) 267-7383	
TITLE: Wallingford Bridge Rehab LOCATION: Wallingford, VT	DRAWING NO: R-1 SHEET NO: 2 of 10
DRAWING TITLE: Drawings Railing System Drawings DRAWN BY: JED CHECKED BY: JED/JAD	JOB CONTACT: Erick Foster State of VT DATE: 4.30.08