



RAILING SYSTEM:

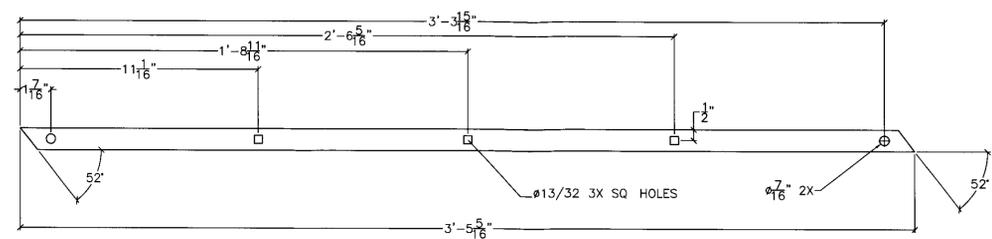

HR01: PLATE-1/4"
 6" = 1'-0" QTY. 216

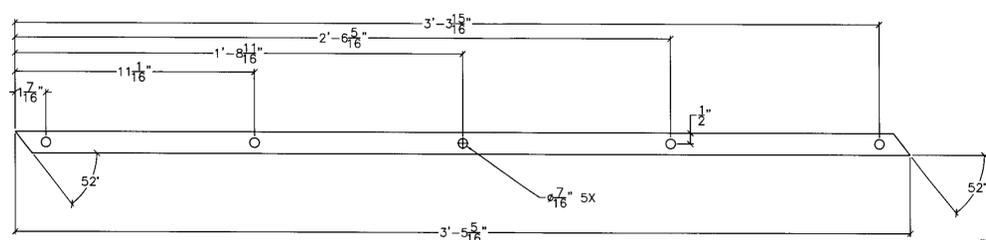

HR02: PLATE-1/4"
 6" = 1'-0" QTY. 216

RECEIVED
 CK'D BY _____ OK'D BY _____
 JUL 31 2011
 BY *W.A. 9/* APPROVED *[initials]*
 DATE *8/1/11*

Renaud Bros. Construction 1000 Main Street Wallingford, VT 05498 (802) 257-7283	
TITLE Wallingford Bridge Rehab	LOCATION Wallingford, VT
DRAWING TITLE Drawings Railing System Drawings	DRAWN BY: JED JOB CONTACT: Erick Foster State of VT
CHECKED BY: JED/AD	DATE: 4 30 09
DRAWING NO. R-1	SHEET NO. 3 OF 10